


O.W.W.O.

Section 16 Township 9 Range 17W

Well No. 1 Carmichael

Company Derby & Peel

Westhusin Pool
NORTH

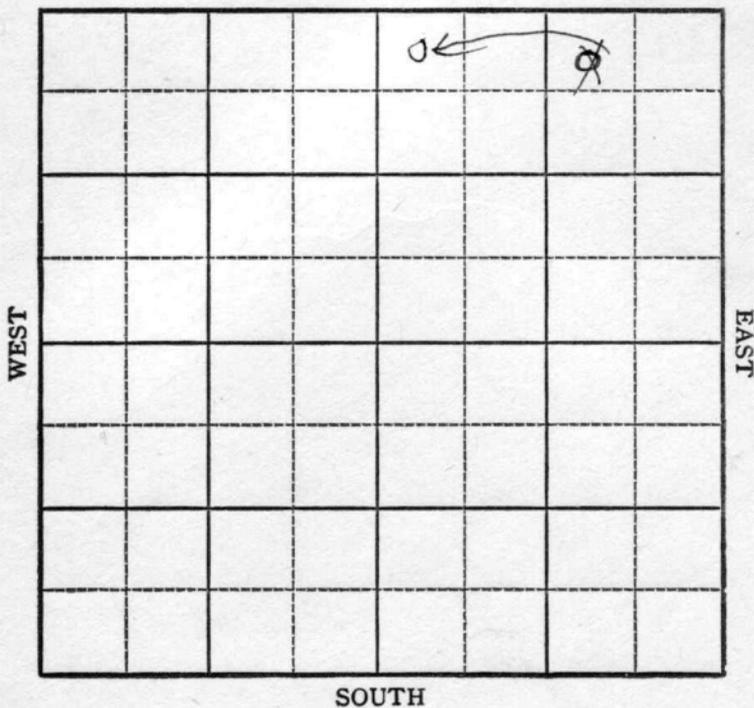

Sec. 16 Twp. 9 R. 17W ✓

Well No. #1 Carmichael Farm

Derby & Peel Company

Westhusin Pool O.W.W.O


330' Ft. from N. Line

_____ Ft. from S. Line

990' Ft. from E. Line

330 Ft. from W. Line

~~NW NE NE~~
NW NW NE

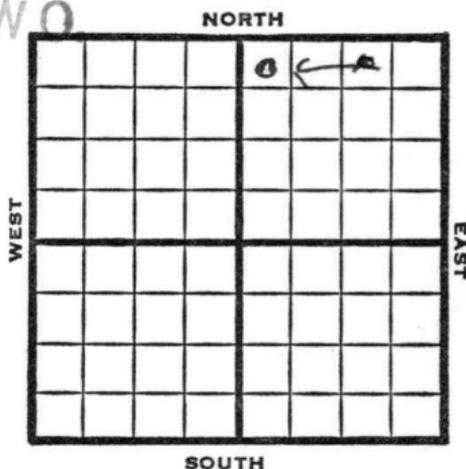

1949

Elev 2077' REPORT

- | | |
|------|----------------------------------|
| 1/12 | Location |
| 1/19 | 8" @ 371' |
| | Drlg 591' |
| 1/26 | " |
| 2/2 | Lansing 3210' |
| | Arbuckle 3490' |
| | TD 3503' |
| | 5" @ 3501' |
| 2/9 | TD 3507' |
| | PB 3422' |
| | 24 shots 3411-19 SO |
| | 1000 acid 1/2 bbls oil PH 5 hrs. |
| 2/16 | " |
| 2/23 | 3000 acid |
| | Swb 20 W PH sqz |
| 3/2 | Arb. 3489 (Corrected) |
| | TD 3503' |
| | Swb 11 3/4 bbls oil 8 hrs. |
| 3/8 | Swb 2 oil PH 4 hrs. |
| 3/16 | " |
| 3/23 | " |
| 3/30 | " |
| 4/6 | TD 3503' |
| | Lans. 3210' |
| | Arb 3499' |
| | 5" @ 3501' |
| | 3000 acid |
| | Pump 25 oil Pot |
| | 37° Gr. |
| | Comp |

COMPLETED OVER

1950

O.W.W.O.

5/10

Lans 3210'

5" @ 3498'

OTD 3502' was producer

D_D 3526 TD

AB 3492

35/2393-99 500 A

24/3462-70 500 A N/3

PB 3488' 1000 A 90 GOPH

PB 3457 23/3447-55 24/3429-38

400 A $1\frac{1}{4}$ BOPH PB 3420

48/3004-16 1000A

S/8 GOPH

Draw in plug 3483

17 BOP 14 hrs.

FIRST REPORT

J
COMPLETED

Map No. _____ Sec. 16 Twp. 9 R. 17W

Well No. 1 Carmichael

Derby & Peel Company

FIRST REPORT

Contractor

NW NE NE

SECTION PLAT

330 Ft. from N. Line

_____ Ft. from S. Line

990 Ft. from E. Line

_____ Ft. from W. Line

| | | | |
|--|--|--|---|
| | | | o |
| | | | |
| | | | |
| | | | |

Rooks County

RECORD

Location X

Cased _____ in., _____ ft.

Rig up _____

Sand _____

Drilling and Remarks:

Gas _____

Oil _____

Total Depth _____

PRODUCTION

1st 24 hrs. Nat. _____

1st 24 hrs. after shot _____

Gas _____ Cu. Ft.

Dry Hole _____

Abandoned _____

Date

JAN 12 1949 19

S. J. LEWIS Scout

Kansas

Map No. 64 Sec. 16 Twp. 9 R. 17W

Well No. 1 Carmichael

Derby & Peel

Company

CORRECTION

Contractor

NW NE


SECTION PLAT

330 Ft. from N. Line

_____ Ft. from S. Line

_____ Ft. from E. Line

330 Ft. from W. Line

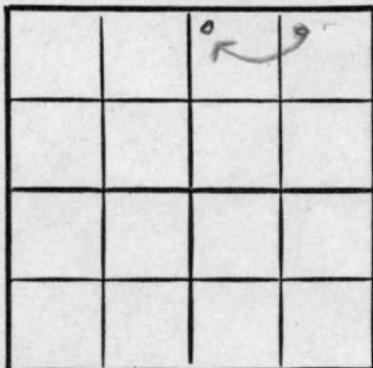

Rooks County

Location _____

Rig up _____

Drilling and Remarks:

Reported

NW NE NE

RECORD

Cased _____ in., _____ ft.

Sand _____

Gas _____

Oil _____

Total Depth _____

PRODUCTION

1st 24 hrs. Nat. _____

1st 24 hrs. after shot _____

Gas _____ Cu. Ft.

Dry Hole _____

Abandoned _____

Date

JAN 19 1949 19

S. J. LEWIS Scout

Kansas

Map No. _____ Sec. 16 Twp. 9 R. 17W
~~15W~~

Well No. 1 Carmichael

Derby Oil etal Company

Contractor

NW NW NE

O.W.W.O.

El. 2077
SECTION PLAT

330 Ft. from N. Line

_____ Ft. from S. Line

_____ Ft. from E. Line

330 Ft. from W. Line

| | | | |
|--------------------------|--|---|--|
| | | 0 | |
| | | | |
| | | | |
| FIRST REPORT COMPLETE | | | |

Rocks OWWO

Location _____

Rig up _____

Drilling and Remarks:

Lans 3210

5" @ 3498

OTD 3502

was producer

D. D. 3526 T. D.

AB 3492 35/2393-90

500 A

RECORD

Cased _____ in., _____ ft.

Sand _____

Gas _____

Oil _____

Total Depth _____

PRODUCTION

1st 24 hrs. Nat. _____

1st 24 hrs. after shot _____

Gas _____ Cu. Ft.

Dry Hole _____

Abandoned _____

Date 24/3462-70 500 A N/3

P. B. 3488 1000A 90G0PH

PB 3457 23/3447-55 24/3429-38

MAY 10 1950 19 J. E. TYRA Scout

400A 1 1/4 BOPH P. B. 3420

48/3004-16

1000A

S/8GPH

Draw in plug 3483

17 BOP 14 Hrs.

Complete

Point 25 200 Hrs. 11-19 Period

ADDRESS

Map No. See

Well No.

Company

Contractor

SECTION PLAT

O.W.W.O.

| | | | |
|--|--|--|--|
| | | | |
| | | | |
| | | | |
| | | | |

Fr. from N. Line

Fr. from S. Line

Fr. from E. Line

Fr. from W. Line

FIRST REPORT COMPLETE

RECORD

Location

Cased in ft.

Scout Cards *OK*

Land Small Map *39*

Land Wall Map

Tracings

France Map

Pierce Map

Misc.

MAY 16 1950

Scout

MAY 14 1950