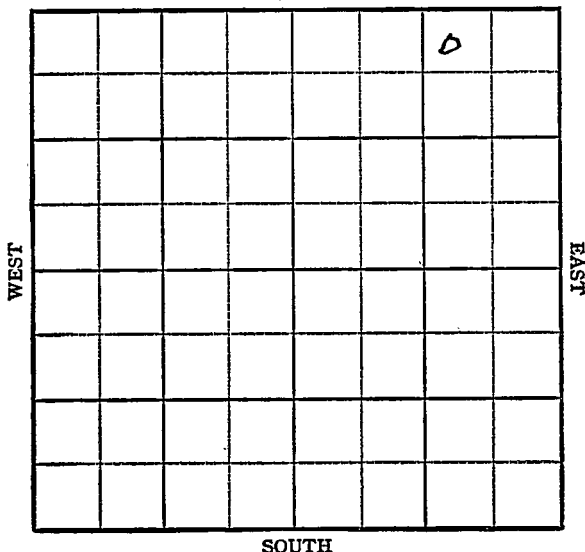


Section 16 Township 9 Range 17WWell No. 2 CarmichaelCompany Derby & PeelWesthusin
NORTH

KANSAS


Rooks

Sec. 16 Twp. 9 R. 17WWell No. #2 Carmichael FarmDerby & Peel Company

Westhusin Pool

330' Ft. from N. Line Ft. from S. Line990' Ft. from E. Line Ft. from W. Line

NW NE NE

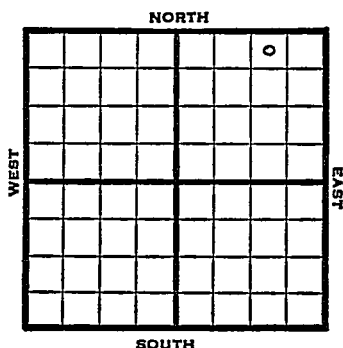

1949

Elev 2077' REPORT

2/2

RUR

2/9

8"@ 367'

Drlg 2920'

2/16

Lansing 3211

Arbuckle 3500-02'

TD 3502'

5"@ 3500'

2/23

300 acid

Swb 5 oil PH 6 hrs.

3/2

"

3/8

"

3/16

"

3/22

"

3/30

"

4/6

TD 3502'

Arb. 3500'

5"@ 3500'

300 acid

Pump 35 oil Pot

37° Gr.

Comp

COMPLETED

Map No. _____ Sec. 16 Twp. 9 R. 17W

Well No. 2 Carmichael

Derby & Peel Company

FIRST REPORT Contractor

NW NE NE

SECTION PLAT

330 Ft. from N. Line

_____ Ft. from S. Line

990 Ft. from E. Line

_____ Ft. from W. Line

			o

Rooks County

Location _____

Rig up _____

Drilling and Remarks:

R U R

RECORD

Cased _____ in., _____ ft.

Sand _____

Gas _____

Oil _____

Total Depth _____

PRODUCTION

1st 24 hrs. Nat. _____

1st 24 hrs. after shot _____

Gas _____ Cu. Ft.

Dry Hole _____

Abandoned _____

Date

FEB 2 1949 19

S. J. LEWIS Scout

Map No. 64 Sec. 16 Twp. 9 R. 17W

Well No. 2 Carmichael

Derby & Peel Company

COMPLETE

Contractor

NW NE NE

E12077

SECTION PLAT

330 Ft. from N. Line

 Ft. from S. Line

990 Ft. from E. Line

 Ft. from W. Line

Rooks County

			0

Location

Rig up

Drilling and Remarks:

At 4000

5' @ 3500

300 acid

Run 3500 ft

37-2-16

RECORD

Cased in., ft.

Sand

Gas

Oil

Total Depth 3502

PRODUCTION

1st 24 hrs: Nat.

1st 24 hrs. after shot

Gas Cu. Ft.

Dry Hole

Abandoned

Date

APR 6 1949 19

S. J. LEWIS Scout