

KANSAS

Rooks

Section 16 Township 9 Range 17W

Well No. 3 Carmichael

Company Derby Oil et al

Westhusin

NORTH

							0

WEST

EAST

SOUTH

KANSAS

Rooks

Sec. 16 Twp. 9 R. 17W ✓

Well No. #3 Carmichael Farm

Derby Oil et al Company

(Pell Drlg. Cont.)

Westhusin Pool


330' Ft. from N. Line

_____ Ft. from S. Line

330' Ft. from E. Line

_____ Ft. from W. Line

NE/C

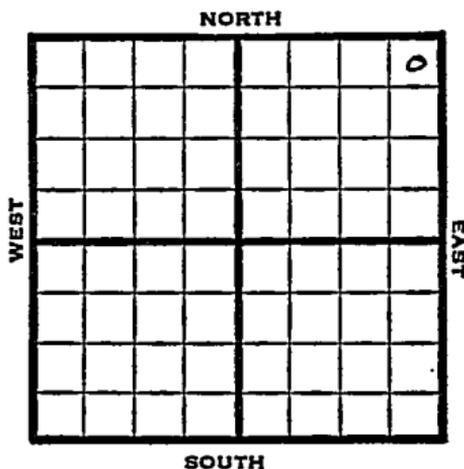

1949

Elev 2055'

REPORT

5/11

Location

5/18

8" @ 394'

Drlg 3320'

5/25

TD 3510'

Lans. 3197'

Cong 3492'

Arb. 3505'

Aband.

ABANDONED

Map No. _____ Sec. 16 Twp. 9 R. 17W

Well No. 3 Carmichael

Derby Oil etal. Company

Peel Drlg. Contractor

NE/C

**FIRST REPORT
 SECTION PLAT**

330 Ft. from N. Line

_____ Ft. from S. Line

330 Ft. from E. Line

_____ Ft. from W. Line

			o

Rooks County

Location X

Rig up _____

Drilling and Remarks:

RECORD

Cased _____ in., _____ ft.

Sand _____

Gas _____

Oil _____

Total Depth _____

PRODUCTION

1st 24 hrs. Nat. _____

1st 24 hrs. after shot _____

Gas _____ Cu. Ft.

Dry Hole _____

Abandoned _____

Date

MAY 11 1949 19

S. J. LEWIS

Scout

Kansas

Map No. K 64 Sec. 16 Twp. 9 R. 17W

Well No. 3 Carmichael

Derby Oil etal. Company

ABANDONED

Contractor

NE/C

E 12055
SECTION PLAT

330 Ft. from N. Line

 Ft. from S. Line

330 Ft. from E. Line

 Ft. from W. Line

			0

Rooks County

Location _____

Rig up _____

Drilling and Remarks:

*Lease 3197
Comp 3492
C 12505*

RECORD

Cased _____ in., _____ ft.

Sand _____

Gas _____

Oil _____

Total Depth 2510

PRODUCTION

1st 24 hrs. Nat. _____

1st 24 hrs. after shot _____

Gas _____ Cu. Ft.

Dry Hole _____

Abandoned _____

Date

MAY 25 1949 19

S. J. LEWIS Scout