

KANSAS

Rooks

Section 16 Township 9 Range 17WWell No. 2 YeagyCompany Alkay Oil

Westhusin

NORTH

			0				

WEST

EAST

SOUTH

KANSAS

Rooks

Sec. 16 Twp. 9 R. 17W ✓Well No. #2 Yeagy Farm

Alkay Oil

Company


Westhusin Pool

330' Ft. from N. Line

Ft. from S. Line

330' Ft. from E. Line

Ft. from W. Line

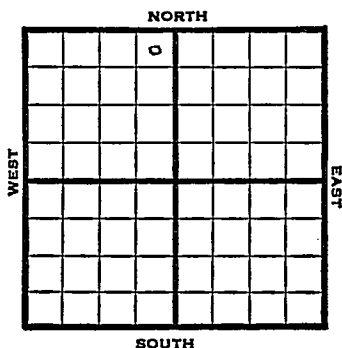

NE NW

1949 Elev. 2061' REPORT

6/1	Location
6/7	TD 3455'
	5" @ 3455'
6/15	"
6/21	Lansing 3201'
	5"@ 3455
	TD 3457'
	21 shots 3446-40
	Bail 1 bbls oil 24 hrs.
6/28	"
7/6	1600 acid
	No Inc.
	12 shots 3417-19
	1200 acid swb 1½ bbls oil PH
7/12	Plug 3409
	12 shots 3392-94'
	1000 acid
7/20	Complete
	Lans. 3201
	5" @ 3455'
	4400 acid
	Pump 15 oil pot.
	27° Grav.
	TD 3457'

COMPLETED

Map No. _____ Sec. 16 Twp. 9 R. 17W

Well No. 2 Yeagy

Alkay Oil

Company

Contractor

NE NW


FIRST REPORT
SECTION PLAT

330 Ft. from N. Line

Ft. from S. Line

330 Ft. from E. Line

Ft. from W. Line

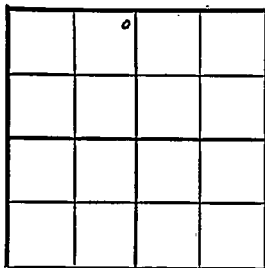

Rooks County

Location X

Rig up

Drilling and Remarks:

RECORD

Cased _____ in., _____ ft.

Sand _____

Gas _____

Oil _____

Total Depth _____

PRODUCTION

1st 24 hrs. Nat. _____

1st 24 hrs. after shot _____

Gas _____ Cu. Ft.

Dry Hole _____

Abandoned _____

Date

JUN 1 1949 19

S. J. LEWIS

Scout

Kansas

Westhusin Pool

Map No. K64 Sec. 16 Twp. 9 R. 17WWell No. 2 Yeagy

Alkay Oil

Company


COMPLETE

Contractor

NE NW

E1. 2061

SECTION PLAT

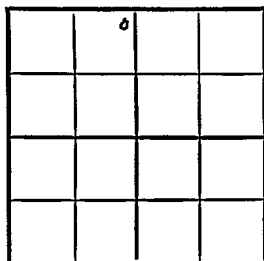330 Ft. from N. Line Ft. from S. Line330 Ft. from E. Line Ft. from W. Line

Rooks County

Location Rig up

Drilling and Remarks:

Line 32015" @ 345 ft.4400 acftPump 15 oil Per270 ft.

RECORD

Cased in., ft.Sand Gas Oil Total Depth 2452

PRODUCTION

1st 24 hrs. Nat. 1st 24 hrs. after shot Gas Cu. Ft.Dry Hole Abandoned

Date

JUL 20 1949 19

S. J. LEWIS Scout