


Section 16 Township 9 Range 18W

Well No. #3 Kaba

Company Cities Service Oil

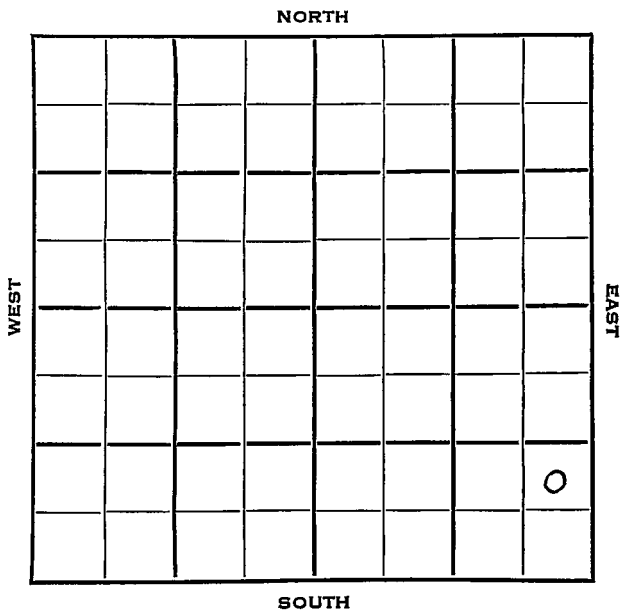

Rooks

KANSAS

SEC.	TWP.	R.
16	9	18 W

WELL NO.

3 Kaba

FARM

COMPANY

Cities Service Oil

CONTRACTOR

Rine Drlg.

Paradise Creek Pool


_____ Ft. from N. Line

990 _____ Ft. from S. Line

330 _____ Ft. from E. Line

_____ Ft. from W. Line

NE SE SE

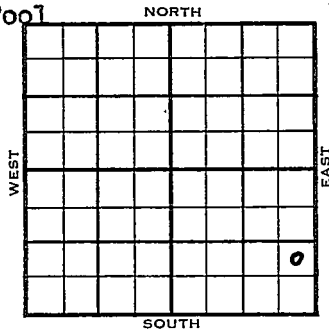

	ELEVATION	REPORT
1953	2141'	
9/23	Spud 9-18-53 8" @ 235' Anhy 1450' Drlg. 2145'	
10/14	NR	
10/21	"	
11/4	"	
11/11	"	
11/18	Spud 9-18-53 Oil Well TD 3557' 8" @ 235' Anhy 1450', Heeb 3265', Dodge 3286, Lans 3309', DST 3390'-3414' opn 1 hr, rec 2140' gco 15' hocom 1080# DST 3471'-95' opn 1 hr, rec 10' Mud Off Arb 3553', TD 3556' 5" @ 3554' DD 3557 FU 500' oil 1 1/4 hr P/ 162 bo 13hr. Comp 296 bopd 60 bw.	

COMPLETED

County Rooks State Kansas

Sec. 16 (Blk. Twp.) 9 (Sur. Rge.) 18W Map No.

Operator Cities Service Oil

Well No. 3 Farm Kaba

Elev. _____ Location NE SE SE

900 Ft. From S Line SE

330 Ft. From 1/2 Line Quarter

1st. Report SEP 23 1953

Completion _____

Remarks _____

Rine Drig. - Contr.

Spudding Date 9-18-53

Drig. Data Paradise Creek Pool

8" @ 235 Anhy 1450 drig. 2145

J. G. McGEHEE

