

Section 16 Township 9 Range 18^WWell No. #1 StahlCompany K & E Drlg.

NORTH

WEST

EAST

SOUTH

Rooks

KANSAS

Sec. 16 Twp. 9 R. 18W

Well No. #1 Stahl Farm

K & E Drlg. Company

Contractor


Ft. from N. Line

330 Ft. from S. Line

330 Ft. from E. Line

Ft. from W. Line

SE SE SW

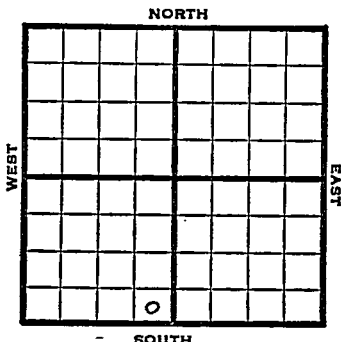

1952

Elev. 2101' REPORT

1/16
2/6

Location

Spud 1-18-52

D&A TD 3560

8" @ 202'

Anhy 1452 Heeb. 3249

Lans. 3293 Arb. 3553-60 TD

D&A


ABANDONED

County Rooks State Kansas
 Sec. 16 (Blk. 9) (Sur. 18W) Map No.

Operator K & E Drlg.

Well No. 1 Farm Stahl

Elev. Location SE SE SW

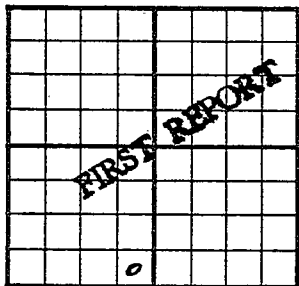

330 Ft. From S Line SW

330 Ft. From E Line Quarter

1st. Report JAN 16 1952

Completion


Remarks

Spudding Date

Drlg. Data

Location

J. E. TYRA

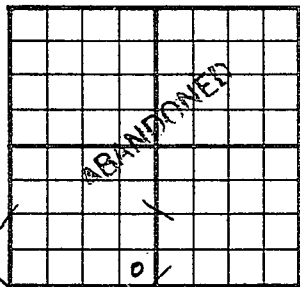County _____ Rooks _____ State KansasSec. 16 (Blk. 9 (Sur. 18W Map No. _____
(Twp.) (Rge.)Operator K & E Drlg.Well No. 1 Farm StahlElev. 2101 Location SE SE SW330 Ft. From S Line SW330 Ft. From E Line Quarter

1st. Report _____

Completion FEB 6 1952

Remarks _____

Spudding Date 1-18-52Drlg. Data D & A TD 35608" @ 202 Anhy 1452 Heeb. 3249Lans. 3292 Arb. 3553-60 TDD & A

J. G. McGEHEE