

Section 16 Township 9 Range 19WWell No. #1 EllettCompany Creekmore Drlg.

NORTH

		0					

WEST

EAST

SOUTH

Rooks KANSAS

Sec. 16 Twp. 9 R. 19 W ✓

Well No. # 1 Ellett Farm

Creekmore Drlg. Company

Wildcat Contractor


330 Ft. from N. Line

Ft. from S. Line

990 Ft. from E. Line

Ft. from W. Line

NW NE SW

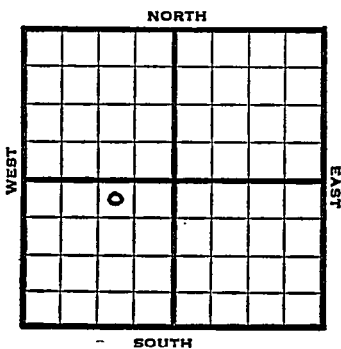

1952

Elev. 2089'

REPORT

1/9

Spud 1-7-52
Set 8" @ ?

1/23

Spud 1-7-52
D & A TD 3728' 8" @ 138
Heeb3265'
DST 3262-3300 open 90 min. rec 65' SW
Lans. 3306' Cong. 3551'
DST 3535-59 open 1 hr. rec 15' SOCM
Arb. 3687'
DST 3695-3728' ppen 90 min. rec 750'
SW.
TD 3728' D & A

ABANDONED

County Rocks State Kansas
 Sec. 16 (Blk.) 9 (Sur.) 19W Map No.
 Operator Creekmore Drlg.
 Well No. 1 Farm Ellett
 Elev. Location NW NE SW

FIRST REPORT									

330 Ft. From N Line SW
990 Ft. From E Line Quarter
 1st. Report JAN 9 1952
 Completion
 Remarks


Spudding Date 1-7-52

Drlg. Data Wildcat

Set 8" @

J. E. TYRA

County _____ Rocks _____ State Kansas
 Sec. 16 (Blk. 9) (Sur. 19W) Map No. _____
 Operator Creekmore Drlg.
 Well No. 1 Farm Ellett
 Elev. 2089 Location NW NE SW

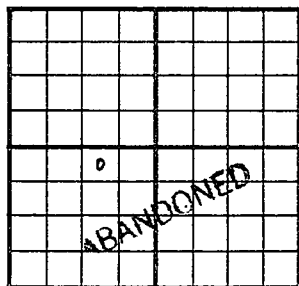

330 Ft. From N Line SW
990 Ft. From E Line Quarter
 Ist. Report _____
 Completion JAN 23 1952
 Remarks Wildcat

Spudding Date 1-7-52

Drlg. Data D & A TD 3728
8" @ 138 Heeb. 3265 DST 3262-3300
open 90 min. Rec. 65' sw Lans. 3306
Cong. 3551 DST 3535-59 open 1 hr.
Rec. 15' socm Arb. 3687 DST 3695-3728
open 90 min. Rec. 750' sw TD 3728
D & A

J. G. McGEHEE