


Section 16 Township 9 Range 20 W

Well No. # 1 Tribble

Company G-M-R Oil

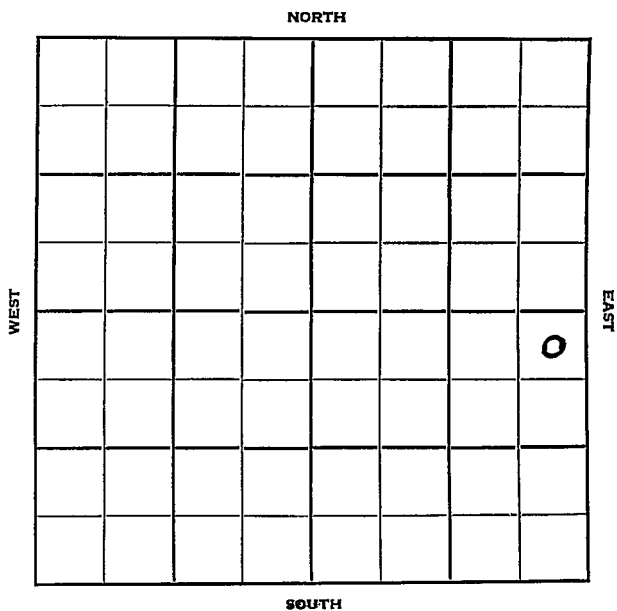



Sec. 16 Twp. 9 R. 20 W

Well No. # 1 Tribble Farm

G-M-R Oil Company

Contractor

Wildcat


330 Ft. from N. Line

Ft. from S. Line

330 Ft. from E. Line

Ft. from W. Line

NE NE SE

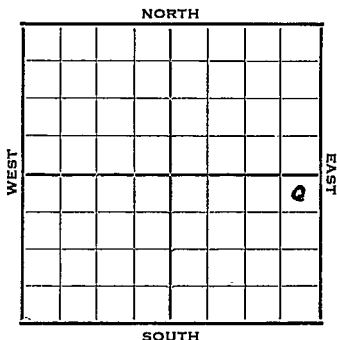

1952

Elev. 2199'

REPORT

7/23

Location

7/30

8" @ 212 Anhy 1684' Heeb 3406'
Tor. 3427' Lans. 3447'
Drlg. 3510'

8/6

Spud 7-23-52
D & A TD 3830' 8" @ 212'
Anhy 1684' Heeb 3406' Tor. 3427'
Lans. 3447' Cong. 3714' ReArb. 3730'
Arb. 3780' TD 3830' D & A

ABANDONED

County _____ Rocks _____ State KansasSec. 16 (Bk.
Twp.) 9 (Sur.
Rge.) 20W Map No. _____Operator G-M-R OilWell No. 1 Farm TribleElev. 2199 Location NE NE SE

330 Ft. From N Line SE330 Ft. From E Line Quarter

1st. Report _____

Completion AUG 6 1952Remarks WildcatSpudding Date 7-23-52Drig. Data D & A TD 38308" @ 212 Anhy 1684 Heeb. 3406Tor. 3427 Lans. 3447 Cong. 3714ReArb. 3730 Arb. 3780 TD 3830D & A