

Section 16 Township 9 Range 20W

Well No. #1 Morris

Company Harry Gore

NORTH

|   |  |  |  |  |  |  |  |
|---|--|--|--|--|--|--|--|
| 0 |  |  |  |  |  |  |  |
|   |  |  |  |  |  |  |  |
|   |  |  |  |  |  |  |  |
4

WEST

EAST

SOUTH

Sec. 16 Twp. 9 R. 20 W

Well No. # 1 Morris Farm

Harry Gore Company

Deek Contractor


Wildcat

330 Ft. from N. Line

\_\_\_\_\_ Ft. from S. Line

\_\_\_\_\_ Ft. from E. Line

330 Ft. from W. Line

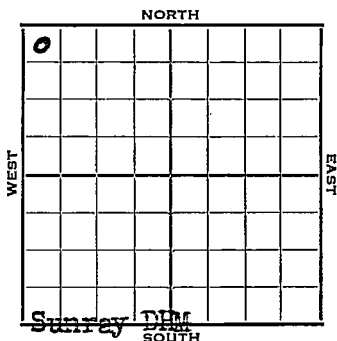

NW NW NW

Continental-FO & \$2500.

Sunray DBM SOUTH

1952 Elev. 2165' DF<sup>R</sup> E P O R T

7/16 Spud 7-10-52  
8" @ 268 w/150  
Drlg. 2530'

7/23 Heeb. 3379 Tor. 3404  
KC 3420 BKG 3635  
Cong. 3702  
Drlg. 3706'

7/30 Spud 7-10-52  
D & A TD 3778' 8" @ 268 Heeb 3379  
Tor. 3404' KC 3420' B KG 3635'  
Cong. 3702' Arb. 3728'  
TD 3778' D & A

**ABANDONED**

County Rooks State KansasSec. 16 (Blk. Twp.) 9 (Sur. Rge.) 20W Map No.Operator Harry GoreWell No. 1 Farm. MorrisElev. 2165 DF Location NW NWNW

|   |  |  |  |  |  |
|---|--|--|--|--|--|
| 0 |  |  |  |  |  |
|   |  |  |  |  |  |
|   |  |  |  |  |  |
330 Ft. From N Line NW330 Ft. From W Line Quarter1st. Report JUL 16 1952

Completion

Remarks Continental -FO #  
\$2500. Sunray-DHM  
Deek- Contr.Spudding Date 7-10-52Drlg. Data Wildcat8" @ 268 W/150 Drlg. 2530

J. G. MCGEE

County Rooks State Kansas

Sec. 16 (Blk. 9) (Sur. Rge.) 20W Map No.

Operator Harry Gore

Well No. 1 Farm Morris

Elev. 2165 Location NW NW NW

|   |  |  |  |  |  |
|---|--|--|--|--|--|
| o |  |  |  |  |  |
|   |  |  |  |  |  |
|   |  |  |  |  |  |
330 Ft. From N Line NW

330 Ft. From W Line Quarter

Ist. Report

Completion JUL 30 1952

Remarks Wildcat

Deek - Contr.

Spudding Date 7-10-52

Drlg. Data D & A TD 3778

8" @ 268 Heeb. 3379 Tor. 3404 KC 3420

B KC 3635 Cong. 3702 Arb. 3728

TD 3778

D & A