


KANSAS Rocks

Section 16 Township 9 Range 20WWell No. 1 TribbleCompany Birmingham & Bartlett

Hampton Pool

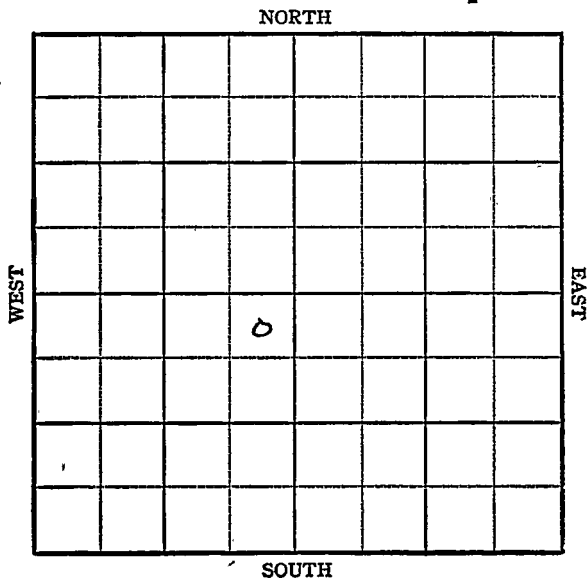

Sec. 16 Twp. 9 R. 20-W ✓

Well No. #1 Tribble Farm
Birmingham & Bartlett Company
Hampton


330 Ft. from N. Line

 Ft. from S. Line

330 Ft. from E. Line

 Ft. from W. Line

NE SW

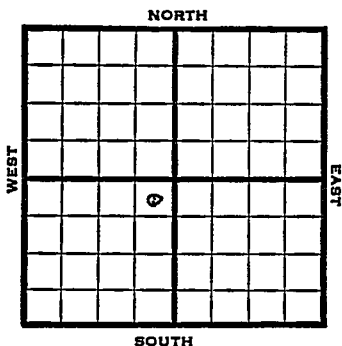

1948

Elev. 2224' REPORT

12/22
12/29

10" @ 228'
Drlg 3465'

1949
1/5

Arb. 3790'
TD 3850'

ABANDONED

Map No. _____ Sec. 16 Twp. 9 R. 20W

Well No. 1 Tribble

Birmingham & Bartlett Company

FIRST REPORT

Contractor

NE SW


SECTION PLAT

330 Ft. from N. Line

_____ Ft. from S. Line

330 Ft. from E. Line

_____ Ft. from W. Line

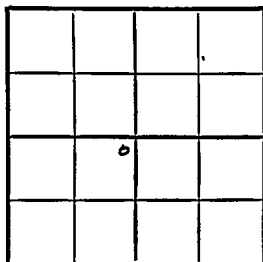

Rooks County

RECORD

Location _____

Cased _____ in., _____ ft.

Rig up _____

Sand _____

Drilling and Remarks:

Gas _____

Oil _____

Total Depth _____

10" @ 228

PRODUCTION

1st 24 hrs. Nat. _____

1st 24 hrs. after shot _____

Gas _____

Cu. Ft.

Dry Hole _____

Abandoned _____

Date

DEC 22 1948

19

S. J. LEWIS

Scout

Kansas

Map No. 65 Sec. 16 Twp. 9 R. 20WWell No. 1 TribbleBirmingham & Bartlett Company


ABANDONED

Contractor

NE SW

E12224

SECTION, PLAT

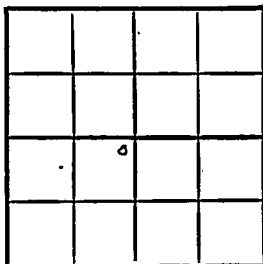330 Ft. from N. Line Ft. from S. Line330 Ft. from E. Line Ft. from W. Line

Rooks County

Location Rig up

Drilling and Remarks:

See 8790

RECORD

Cased in., ft.Sand Gas Oil Total Depth 3850

PRODUCTION

1st 24 hrs. Nat. 1st 24 hrs. after shot Gas Cu. Ft.Dry Hole Abandoned

Date

JAN 5 1949 19 S. J. LEWIS Scout