


Graham **KANSAS**

SECTION 16 TOWNSHIP 9 RANGE 21W

WELL NO. #13 Anderson "A"

COMPANY Barnett Oil

NORTH SE SE SW

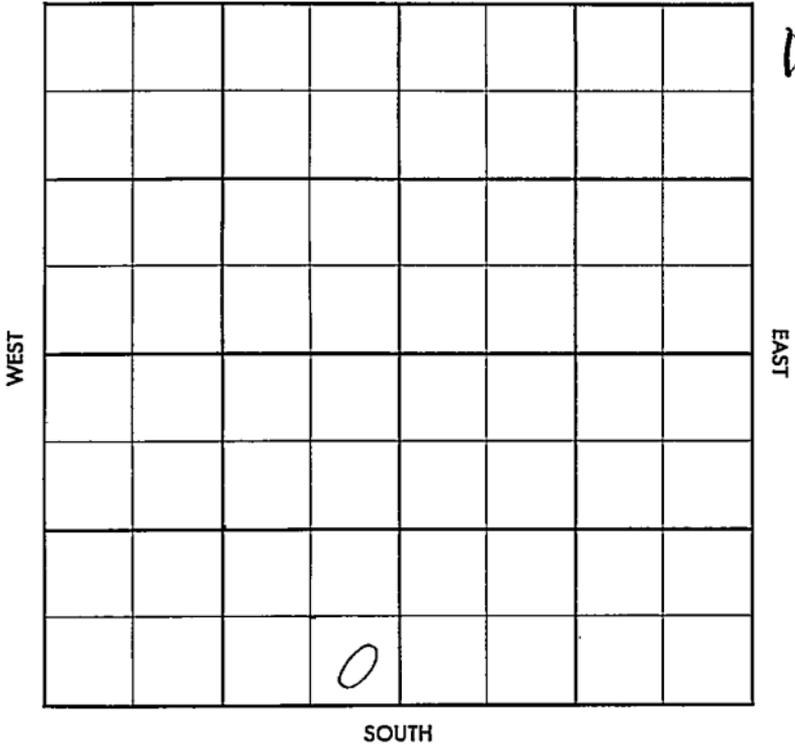

County Graham Elev. _____
 Sec. 16 Twp. 9 Rge. 21W
 Company Barnett Oil
 Farm Name Anderson "A" No. 13

TOPS	DEPTH	LOG	DATUM
Anh.			
Top.			
H.			
Tr.			
Dg.			
Bl.			
L.			
K.C.			
B.K.C.			
Ce.			
C.			
M.			
M.			
K.			
Mz.			
Ma.			
V.			
S.			
S.			
A.			
R.			
Pe.			
G.			
T.D.			

Loc. in Sec. SE SE SW

Geol. _____

Contr. Barnett

Pool Morel

	JAN 30 '57	
FIRST REPORT		

Date Comm. M I R

~~Handwritten signature or scribble~~

Co.
Lse.
T.
No.
Sec.
R.

Co.

Use

No.

Sec.

T.

R.

County Graham Elev. 2240
 Sec. 16 Twp. 9 Rgs. 21W
 Company Barnett Oil
 FarmName Andreson "A" No. 13

TOPS	DEPTH	LOG	DATUM
Anh.			
Tp.			
H.	3390		
Tr.			
Dg.			
Bl.			
L.	3430		
K.C.			
B.K.C.			
Ce.			
C.			
M.			
M.			
K.			
Mz.			
Mo.			
V.			
S.			
S.			
A.	3720		
R.			
PE.			
G.			
TD.	3775		

Loc. in Sec. SE SE SW

Geol. _____
 Contr. Barnett

Pool Morel

COMPLETE
 FEB 27 '57

Date Comm. M I R FEB 28 1957 85/8
152/125 @ 3770 FEB 27 5 1/2
3774/125 MICT ... CO 3766
GRNL 18/3732-38 FU 1050'
350' oil 1hr 600' oil in 2hrs
Pop Ph P. 192 Bopd
no water