


Section 16 Township 9 Range 21-W

Well No. #9 Anderson

Company Barnett Oil

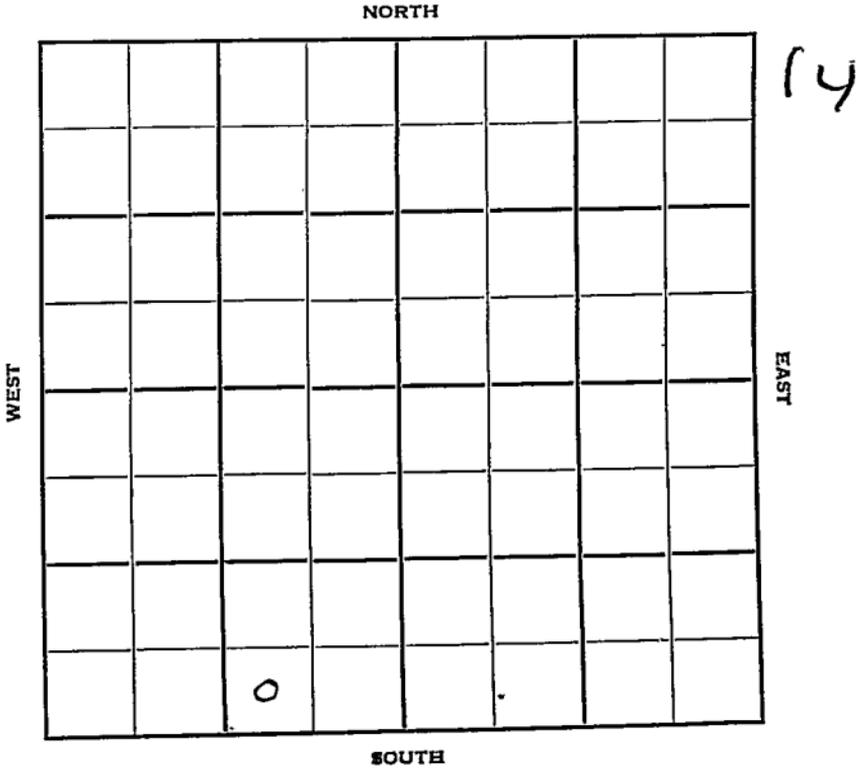

Sec. 16 Twp. 9 R. 21-W

Well No. #9 Anderson Farm

Barnett Oil Company

Barnett Contractor

Morel


_____ Ft. from N. Line

330 Ft. from S. Line

990 Ft. from E. Line

_____ Ft. from W. Line

SW SE SW

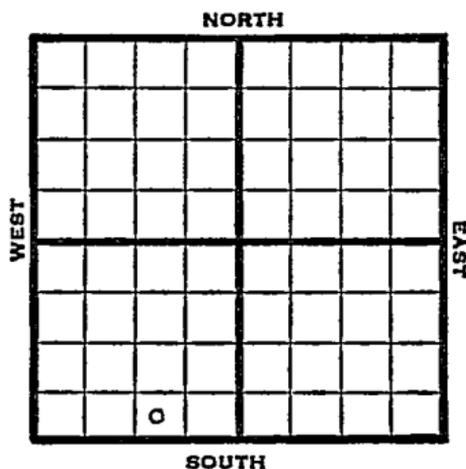

1950

Elev 2249

REPORT

8/2 Location Spud 8-2-50

8/30 8" @ 147
 Anhy 1712 KC 3444
 Arb 3739
 5" @ 3740
 TD 3745
 FU 1750' oil in 5 hr
 S/4 1/2 bo 1 hr
 4 3/4 bo 2nd hr
 S/9 boph
 500 A
 Comp 2250 bopd
 Completed

COMPLETED

(ans²³)

Map No. _____ Sec. 16 Twp. 9 R. 21W

Well No. 9 Andreson

_____ Barnett Oil _____ Company

_____ Barnett _____ Contractor

SW SE SW

SECTION PLAT

_____ Ft. from N. Line

330 Ft. from S. Line

990 Ft. from E. Line

_____ Ft. from W. Line



Graham County

Location X

Rig up _____

Drilling and Remarks:

RECORD

Cased _____ in., _____ ft.

Sand _____

Gas _____

Oil _____

Total Depth _____

PRODUCTION

1st 24 hrs. Nat. 19 _____

1st 24 hrs. after shot _____

Gas _____ Cu. Ft.

Dry Hole _____

Abandoned _____

Date

AUG 2 1950 19

J. E. TYRA

Scout

