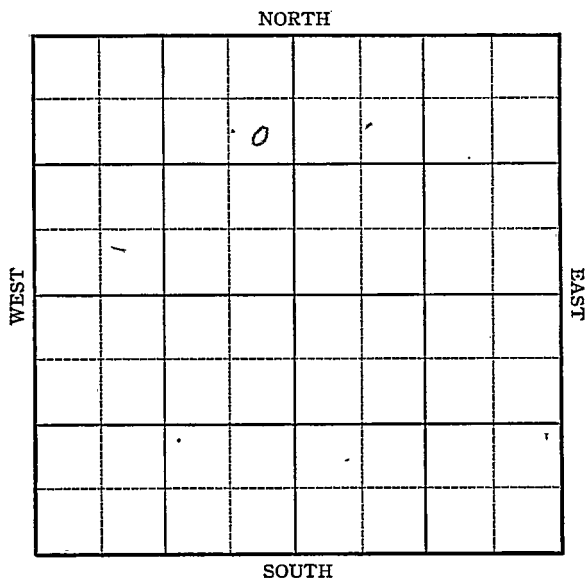


KANSAS

Graham

Section 16- Township 9 Range 21WWell No. #2 BolandCompany Barnett Drlg. et al

KANSAS

Graham

Sec. 16 Twp. 9 R. 21W

Well No. #2 Boland Farm

Barnett Drlg. et al Company


Morel

990 Ft. from N. Line

 Ft. from S. Line

330 Ft. from E. Line

 Ft. from W. Line

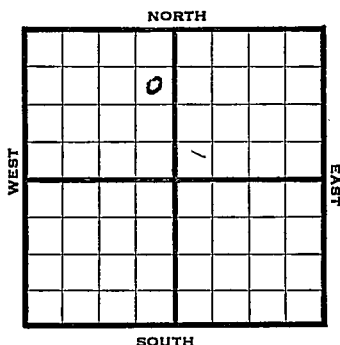

REPORT

1944

7/19 10" @ 157'
TD 3210' Drlg.

7/26 Lans 3392
Cong 3708
Art 3761
TD 3791

ABANDONED

KANSAS Pool Name More 1
 Map No. (2) Sec. 16 Twp. 9 R. 21W
 Well No. 2 Boland

Barnett Drig. etal. Company

FIRST REPORT

Contractor

SE NE NW

SECTION PLAT

990 Ft. from N. Line

 Ft. from S. Line

330 Ft. from E. Line

 Ft. from W. Line

Graham County

Location

Rig up

Drilling and Remarks:

10" - 157

3210

RECORD

Cased in., ft.

Sand

Gas

Oil

Total Depth

PRODUCTION

1st 24 hrs. Nat.

1st 24 hrs. after shot

Gas Cu. Ft.

Dry Hole

Abandoned

Date

JUL 1 9 1944 19

S. J. LEWIS Scout

KANSAS

Pool Name Morel PoolMap No. 65 Sec. 16 Twp. 9 R. 21WWell No. 2 BolandBarnett Drlg. etal.

Company

ABANDONED

Contractor

SE NE NW

SECTION PLAT

	o		

990 Ft. from N. Line Ft. from S. Line330 Ft. from E. Line Ft. from W. LineGraham CountyLocation Rig up

Drilling and Remarks:

Leak 3392Comp 3708273761

RECORD

Cased in., ft.Sand Gas Oil Total Depth 3791

PRODUCTION

1st 24 hrs. Nat. 1st 24 hrs. after shot Gas Cu. Ft.Dry Hole Abandoned

Date

JUL 26 1944

19

S. J. LEWIS

Scout