

Section 16 Township 9 Range 21 WWell No. # 8 BolandCompany Barnett Oil

		0					

NORTH

WEST

EAST

SOUTH

3

Graham KANSAS ✓


Sec. 16 Twp. 9 R. 21WWell No. #8 Boland FarmBarnett Oil CompanyBarnett Drlg. ContractorMorel Pool330 Ft. from N. Line

Ft. from S. Line

990 Ft. from E. Line

Ft. from W. Line

NW NE NW

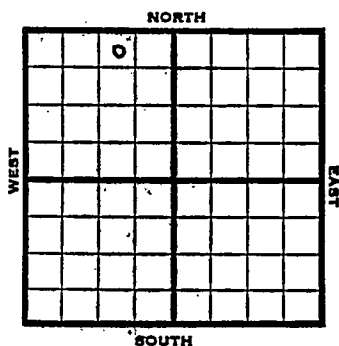

1953 Elev. 2212' REPORT

5/13 Spud 5-4-53
 8" @ 138
 Heeb 3378, Lans 3418
 Drlg. 3446'

5/20 Spud 5-4-53 D & A TD 3820
 8" @ 138 Heeb 3378 Lans 3418
 B KG 3631 Cong. 3718
 DST 3718-30 open $\frac{1}{2}$ hr rec 8' mud O#
 Arb. 3785
 TD 3820 D & A


ABANDONED

County Graham State Kansas
 Sec. 16 (Blk. 9 (Sur. 21W Map No.
 (Twp.) (Rge.)
 Operator Barnett Oil
 Well No. 8 Farm Boland
 Elev. 2212 Location NW NE NW

		0				

330 Ft. From N Line NW
990 Ft. From E Line Quarter
 Ist. Report MAY 13 1953
 Completion
 Remarks
Barnett Drlg. - Contr.
 Spudding Date 5-4-53

Drlg. Data Morel Pool
8" @ 138 Heeb. 3378 Lens. 3418
drlg. 3446

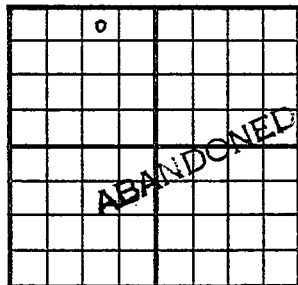County Graham State KansasSec. 16 (Blk. 9) (Sur. 21W) Map No. Operator Barnett OilWell No. 8 Farm BolandElev. 2212 Location NW NE NW330 Ft. From N Line NW990 Ft. From E Line Quarter1st. Report Completion MAY 20 1953Remarks Morel PoolBarnett Drlg. - Contr.Spudding Date 5-4-53Drlg. Data D & A TD 38208" @ 138 Heeb. 3378 Lans. 3418B KC 3631 Cong. 3718 DST 3718-30open $\frac{1}{2}$ hr. Rec. 8' mud 0# Arb. 3785TD 3820D & A