

KANSAS


Graham

Section 16 Township 9 Range 21WWell No. 1 Clack "B"Company Cities Service

Morel

NORTH

WEST

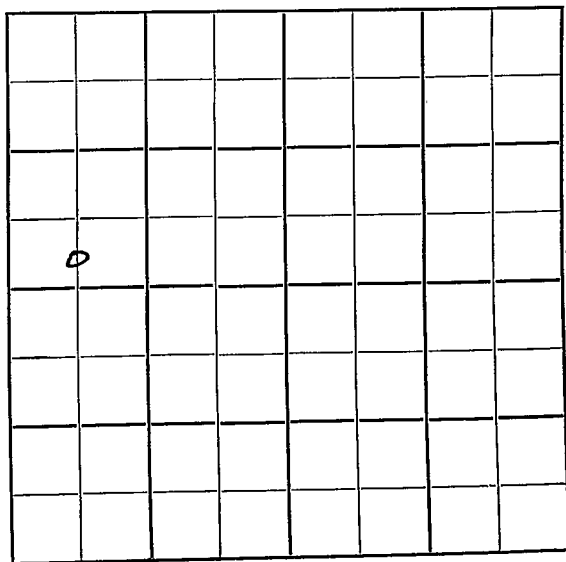

EAST

SOUTH

KANSAS

Graham

Sec. 16 Twp. 9 R. 21W ✓Well No. #1 Clack "B" Farm

Cities Service

Company

Morel Pool

Ft. from N. Line


330'

Ft. from S. Line

Ft. from E. Line

660'

Ft. from W. Line

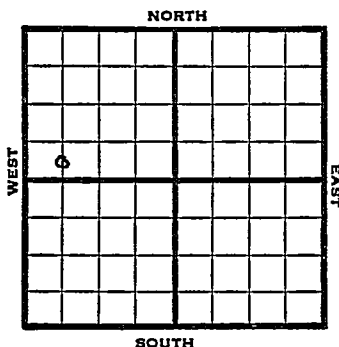

C S. L SW NW

Elev. 2204' REPORT

1949

Location

"

8" @ 252'

Drlg 3275'

Lansing 3389'

Arb. 3678'

TD 3685

5" @ 3681'

"

SLM 3685-88'

Lans 3392'

Arb. 3681

5" @ 3684

TD 3700'

Pump 41 bbls oil 8 hrs.

1000 acid

TD 3704'-2900' oil

500 acid

"

"

"

"

"

"

"

Arb 3681'

5" @ 3681'

1500 acid

Pump 441 oil Pot.

Gr. 30°

TD 3704'

COMPLETED

Map No. _____ Sec. 16 Twp. 9 R. 21W

Well No. 1 Clack "B"

Cities Service

Company

FIRST REPORT

Contractor

C S L SW NW

SECTION PLAT

_____ Ft. from N. Line

330

_____ Ft. from S. Line

_____ Ft. from E. Line

660

_____ Ft. from W. Line

Graham County

Location X

Rig up _____

Drilling and Remarks:

RECORD

Cased _____ in., _____ ft.

Sand _____

Gas _____

Oil _____

Total Depth _____

PRODUCTION

1st 24 hrs. Nat. _____

1st 24 hrs. after shot _____

Gas _____ Cu. Ft.

Dry Hole _____

Abandoned _____

Date

APR 13 1949

S. J. LEWIS

Scout

Morel Pool

Map No. K65 Sec. 16 Twp. 9 R. 21WWell No. 1 Clark "B"

Cities Service

Company

COMPLETE

Contractor

C S L SW NW

E1,2204
SECTION PLAT

Ft. from N. Line

330

Ft. from S. Line

Ft. from E. Line

660

Ft. from W. Line

0			

Grahams County

Location

Rig up

Drilling and Remarks:


RECORD

Cased _____ in., _____ ft.

Sand _____

Gas _____

Oil _____

Total Depth 13204

PRODUCTION

1st 24 hrs. Nat. _____

1st 24 hrs. after shot _____

Gas _____ Cu. Ft.

Dry Hole _____

Abandoned _____

Date

JUL 6 1949

19

S. J. LEWIS

Scout