


Section 16 Township 9 Range 21W

Well No. #4 Drumm

Company Continental  
Morel Pool

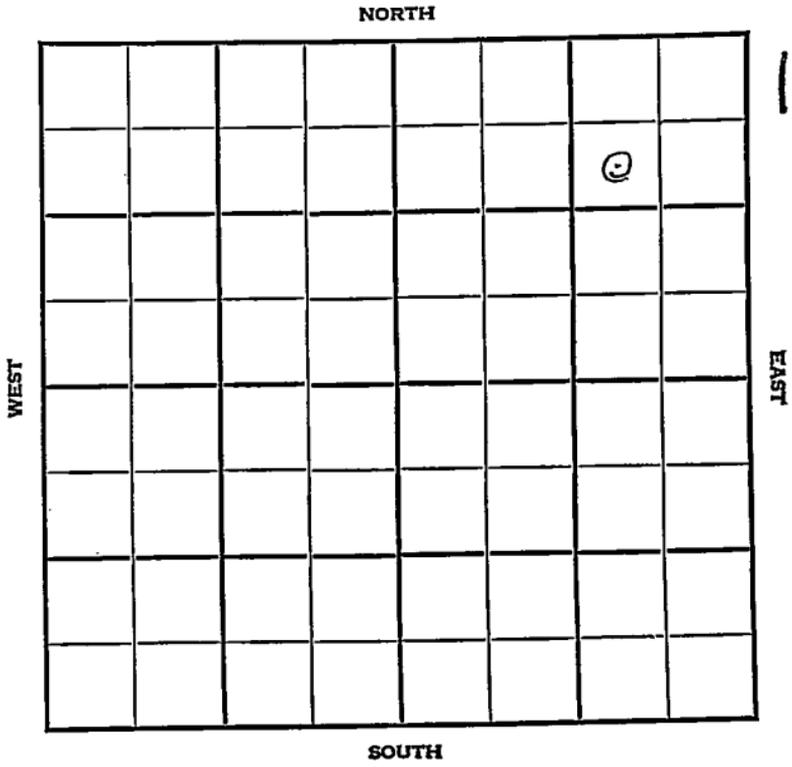

KANSAS

Graham County



Sec. 16 Twp. 9 R. 21W

Well No. #4-Drumm Farm

Continental Oil Co. Company

Morel Pool


990' Ft. from N. Line

Ft. from S. Line

990' Ft. from E. Line

Ft. from W. Line

SW NE NE

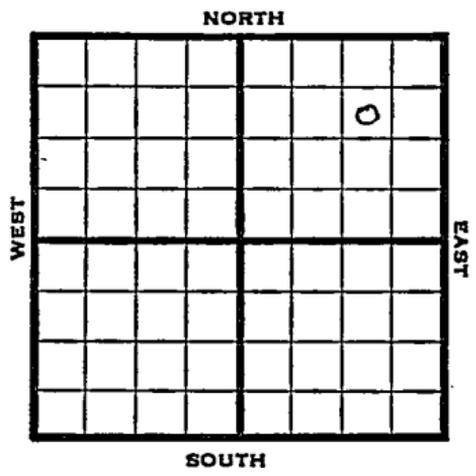

1948

Elev. 2174' REPORT

- 4/21 Derrick
- 4/28 "
- 5/5 10" @ 384'  
Drlg. 1205'
- 5/12 Drlg. 3410'
- 5/19 Arbuckle 3667'  
TD 3672'  
6" @ 3668'  
RUST
- 6/1 Arbuckle 3667'  
6" @ 3668'  
Acid 2000  
Pump 601 oil Pot.  
Gr. 27°  
TD 3674'

**COMPLETED**

Map No. \_\_\_\_\_ Sec. 16 Twp. 9 R. 21W

Well No. 4 Drumm

\_\_\_\_\_ Continental \_\_\_\_\_ Company

\_\_\_\_\_ **FIRST REPORT** \_\_\_\_\_ Contractor

SW NE NE<sup>E</sup>

SECTION PLAT

990 Ft. from N. Line

\_\_\_\_\_ Ft. from S. Line

990 Ft. from E. Line

\_\_\_\_\_ Ft. from W. Line

			e

Graham County

Location \_\_\_\_\_

Rig up \_\_\_\_\_

Drilling and Remarks:

Derrick

RECORD

Cased \_\_\_\_\_ in., \_\_\_\_\_ ft.

Sand \_\_\_\_\_

Gas \_\_\_\_\_

Oil \_\_\_\_\_

Total Depth \_\_\_\_\_

PRODUCTION

1st 24 hrs. Nat. \_\_\_\_\_

1st 24 hrs. after shot \_\_\_\_\_

Gas \_\_\_\_\_ Cu. Ft.

Dry Hole \_\_\_\_\_

Abandoned \_\_\_\_\_

Date

APR 21 1948

19

S. J. LEWIS

Scout

