

KANSAS

Form 51—5M—11-38—Palace


Graham

Section 16 Township 9 Range 21-W

Well No. #1 Kolste

Company Continental

NORTH Morel Pool

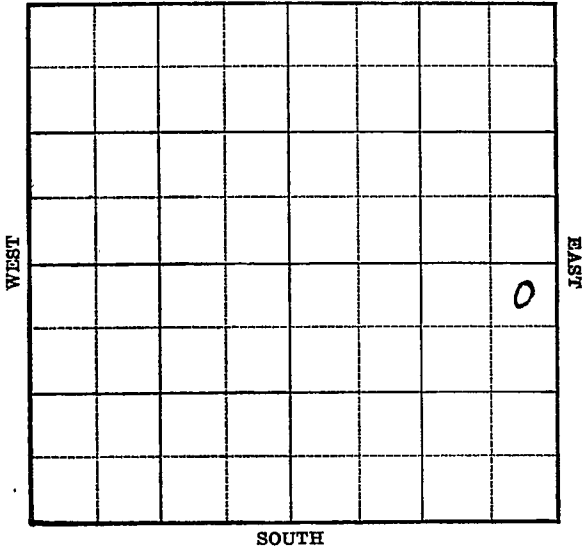

KANSAS

Graham

Sec. 16 Twp. 9 R. 21-WWell No. #1 Kolste FarmContinental Company


(Morel)

330 Ft. from N. Line

Ft. from S. Line

330 Ft. from E. Line

Ft. from W. Line

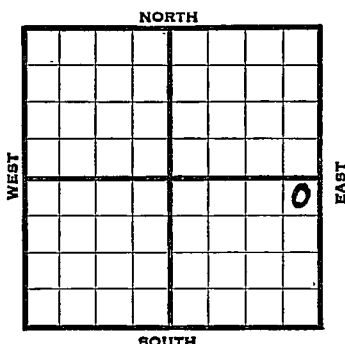

Elev. 2222'

1939	REPORT
3/8	Location
3/17	R.U.R.
3/24	13" - 246' WOC.
3/31	Drlg. 1739'
4/7	9" - 1487'
	Any 1706' (Corrected)
	Drlg. 2844'
4/14	Lans. 3450' S.O. 3610-18'
	Arb. Congl. 3727' Coring 3748'
	No shows.
4/21	Cong. 3727' instead of Arb.
	Drlg. 3845' in Cong. No oil.
4/28	Arb. 3874' T.D. 3884' No oil.
	Will deepen for salt wtr.
	disposal.
5/5	7" - 4034' T.D. 4042'
	plug back.
5/12	P. B. 3650' 50 shots 3606½ to 3617½' water.
5/19	Drlg. 4095'
	OVER

1939
5/24

Arb. 3874'

7" - 4034'

T.D. 4218'

6000 acid.

Input 240 water per hour.

Salt water disposal well.

ABANDONED

Graham

KANSAS

Map No. 65 Sec. 16 Twp. 9 R. 21WWell No. 1 KolsteContinental

Company

Contractor

FIRST REPORT

NE SE

330 Ft. from N. Line Ft. from S. Line330 Ft. from E. Line Ft. from W. Line

SECTION PLAT

	*		
			0

MOREL POOL

Location XRig up

Drilling and Remarks:

RECORD

Cased in., ft.Sand Gas Oil Total Depth

PRODUCTION

1st 24 hrs. Nat. 1st 24 hrs. after shot Gas Cu. Ft.Dry Hole Abandoned

Date

MAR 8 - 1939

19

H. D. Hatfield

Scout

Graham KANSAS

Map No. 65 Sec. 16 Twp. 9 R. 21WWell No. 1 KolsteContinental

Company

Contractor


COMPLETE

SECTION PLAT

NE SE

330 Ft. from N. Line Ft. from S. Line330 Ft. from E. Line Ft. from W. Line

MOREL POOL

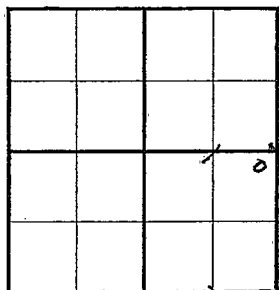Location Rig up

Drilling and Remarks:

*Cu & 3874**7" @ 4034**6000 acid**inj & 240 water**use hr.**Water Disposal Well*

RECORD

Cased in., ft.Sand Gas Oil Total Depth 4218

PRODUCTION

1st 24 hrs. Nat. 1st 24 hrs. after shot Gas Cu. Ft.Dry Hole Abandoned

Date

MAY 24 1939

19

S. J. LEWIS

Scout