


Section 16 Township 9 Range 21-W

Well No. 1 Drumm Commission Co.

Company Continental

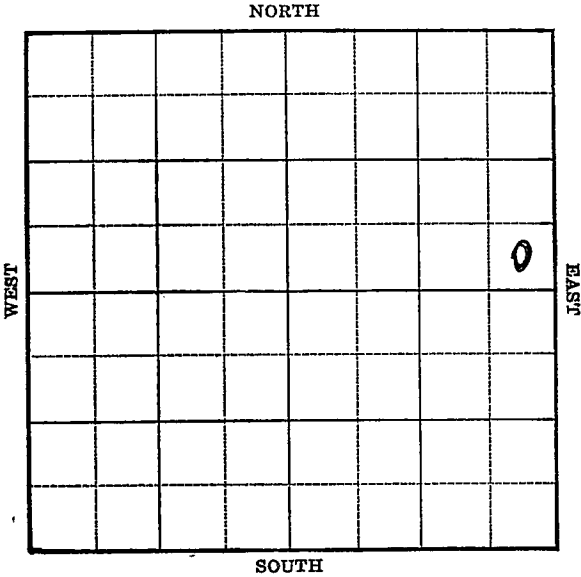

8

KANSAS

Graham

Sec. 16 Twp. 9 R. 21-W

Well No. #1 Drumm Commission Co. Farm
Continental Company

(Wildcat)


Ft. from N. Line

330 Ft. from S. Line

330 Ft. from E. Line

Ft. from W. Line

Elev. 2200

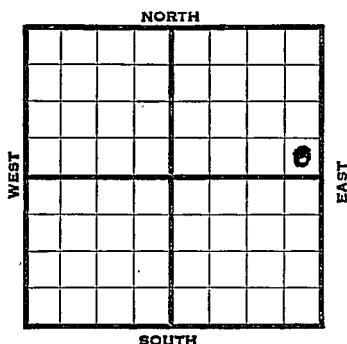

1939	REPORT
1/4	R.R.
1/13	13" - 241'. Drlg. 1700'.
1/20	Anhy 1661'. 10" - 1494'.
	Drlg. 2462'..
1/27	Topeka 3150'. Lans. 3390'.
	Arb. ³⁶⁷⁹ 3684-99 T.D. Good S. O.
	5" - 3685 ³⁶⁸¹ .
2/3	T. D. 3702'. 800' oil 7 hrs.
2/10	3699 equals 3694'.
	Arb. 3679'. 5" - 3681'.
	T.D. 3702. 800' oil 7 hrs.
	No test natural.
	1000 acid. 2900' oil in 22 Min.
	SD for tanks.
2/17	Swab 12 oil per hr. 5 hrs.
	SD for tanks.
2/23	Pump 149 oil in 8½ hours.
	4000 acid.
	OVER

1939

3/1

5" - 3685'

Arb. 3684'

T. D. 3702'

5000 acid (Total)

Pump 348 bbls. 8 hrs.

Potential 1043 bbls.

Gravity 27.4/61

COMPLETED

Graham

KANSAS

Map No. 65 Sec. 16 Twp. 9 R. 21WWell No. 1 Drumm Commission Co.Continental

Company

Contractor

FIRST REPORT

SE NE

 Ft. from N. Line330 Ft. from S. Line330 Ft. from E. Line Ft. from W. Line

SECTION PLAT

			0

WILDCAT

Location Rig up

Drilling and Remarks:

RR

RECORD

Cased in., ft.Sand Gas Oil Total Depth

PRODUCTION

1st 24 hrs. Nat. 1st 24 hrs. after shot Gas Cu. Ft.Dry Hole Abandoned

Date

JAN 4 - 1938 19

I. D. Hatfield

Scout

Graham

Map No. 65 Sec. 16 Twp. 9 R. 21WWell No. 1 Drumm Commission Co.Continental Company

Contractor

COMPLETED

SE NE

SECTION PLAT

			0

 Ft. from N. Line330 Ft. from S. Line330 Ft. from E. Line Ft. from W. Line~~WILDCAT~~Extension To Morel Pool ?Location Rig up

Drilling and Remarks:

5000 Acid (Total)P- 348/8Pot 1043grau 27.4/61

RECORD

Cased 5 in., 3685 ft.Sand Arb. 3684Gas Oil Total Depth 3702

PRODUCTION

1st 24 hrs. Nat. 1st 24 hrs. after shot Gas Cu. Ft.Dry Hole Abandoned

Date

MAR 1 - 1939 19E. D. Hatfield Scout