


Graham county

Section 16 Township 9 Range 21-W

Well No. #3, Drumm

Company Continental Oil Company

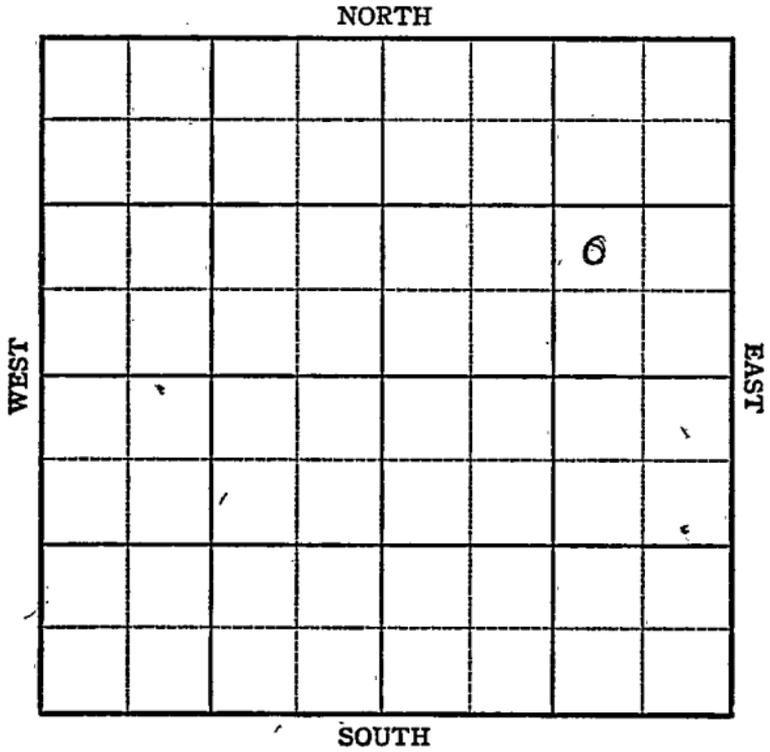

Sec. 16 Twp. 9 R. 21W

Well No. 3 Drumm Farm

Continental Oil Company


Morel Pool

Ft. from N. Line

990 Ft. from S. Line

990 Ft. from E. Line

Ft. from W. Line

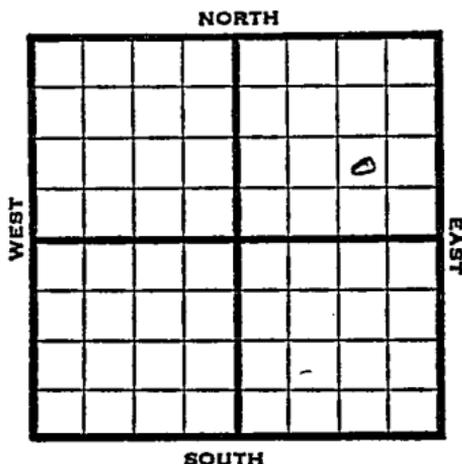

NW SE NE

1947 Elev. 3685 REPORT

1/2 Location

1/8 13" @ 239'
Drlg 475'

1/15 Arb 3669
75 TD
Run 6"

1/21 6" @ 3670
RUST

2/5 TD 3685'
Arb 3669'
6" @ 3670'
Depth Pot. 2091
Grav. 27

COMPLETED

Kansas **KANSAS**Map No. 65 Sec. 16 Twp. 9 R. 21WWell No. 3 DrummContinental Oil Company**FIRST REPORT**

Contractor

NW SE NE

SECTION PLAT

			0

_____ Ft. from N: Line

990 Ft. from S. Line990 Ft. from E. Line

_____ Ft. from W. Line

Graham County

Location X

Rig up _____

Drilling and Remarks:

RECORD

Cased _____ in., _____ ft.

Sand _____

Gas _____

Oil _____

Total Depth _____

PRODUCTION

1st 24 hrs. Nat. _____

1st 24 hrs. after shot _____

Gas _____ Cu. Ft.

Dry Hole _____

Abandoned _____

Date

JAN 2 1947 19S. J. LEWIS Scout

