

Section 16 Township 9 Range 21-W

Well No. 3 Kolste

Company Derby Oil

Morel Pool

NORTH

WEST

EAST

						Q	

SOUTH

16

Sec. 16 Twp. 9 R. 21W

Well No. #3 Kolste Farm

Derby Oil Company

Morel


 Ft. from N. Line

990 Ft. from S. Line

990 Ft. from E. Line

 Ft. from W. Line

NW SE SE .

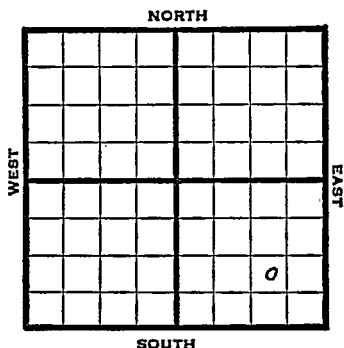

1947

Elev. 2221'

R E P O R T

9/24 10" @ 349'
Drlg. 2750'

10/1 Lansing 3419'
BKC 3646'
Drlg. 3772'

10/8 Arbuckle 3744'
TD 3748'
5" @ 3744'
500 acid
Swb 7 bbls oil PH, 7 hrs.

10/15 "

10/22 "

10/29 Arbuckle 3744'
5" @ 3744'
500 Acid
Pump 497 Pot.
TD 3748'
Gravity 27

COMPLETED

Map No. _____ Sec. 16 Twp. 9 R. 21W

Well No. 3 Kolste

Derby Oil

Company

FIRST REPORT

Contractor

NW SE SE


SECTION PLAT

_____ Ft. from N. Line

990 Ft. from S. Line

990 Ft. from E. Line

_____ Ft. from W. Line

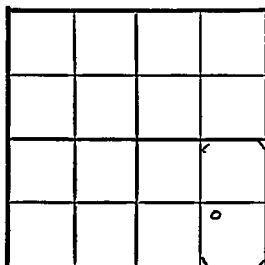

Graham County

Location _____

Rig up _____

Drilling and Remarks:

10" @ 349

drlg. 2750

RECORD

Cased _____ in., _____ ft.

Sand _____

Gas _____

Oil _____

Total Depth _____

PRODUCTION

1st 24 hrs. Nat. _____

1st 24 hrs. after shot _____

Gas _____ Cu. Ft.

Dry Hole _____

Abandoned _____

Date

SEP 24 1947

19

S. J. LEWIS

Scout

Map No. 105 Sec. 16 Twp. 9 R. 21W

Well No. 3 Kolste

Derby Oil Company

COMPLETE

Contractor

NW SE SE

E 12221

SECTION PLAT

 Ft. from N. Line

990 Ft. from S. Line

990 Ft. from E. Line

 Ft. from W. Line

Graham County

Location

Rig up

Drilling and Remarks:






RECORD

Cased in., ft.

Sand

Gas

Oil


PRODUCTION

1st 24 hrs. Nat.

1st 24 hrs. after shot

Gas Cu. Ft.

Dry Hole

Abandoned

Date

OCT 29 1947

19

S. J. LEWIS

Scout