
FORM 51 25M 3-49 PETROL

Graham KANSAS

Section 16 Township 9 Range 22W

Well No. #1 - Walker

Company Aurora Gas

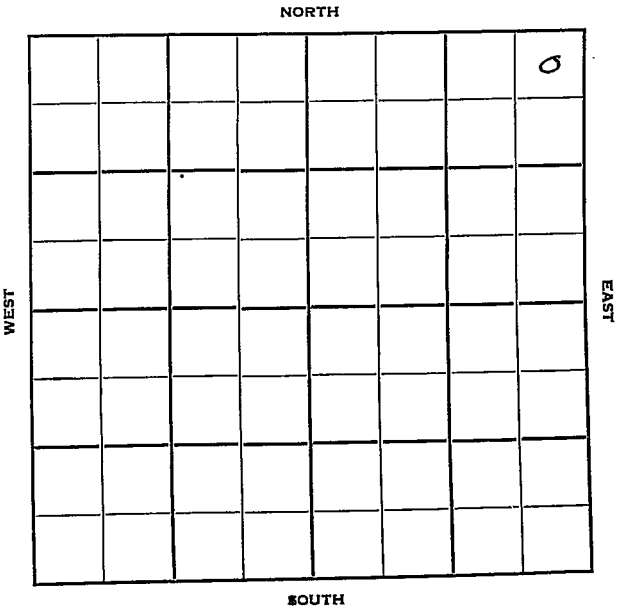

FORM 252-B
10M 9-49 PETROL

Graham KANSAS

Sec. 16 Twp. 9 R. 22W

Well No. #1 Walker Farm

Aurora Gas Company

Contractor


330' Ft. from N. Line

Ft. from S. Line

330' Ft. from E. Line

Ft. from W. Line


NE NE NE

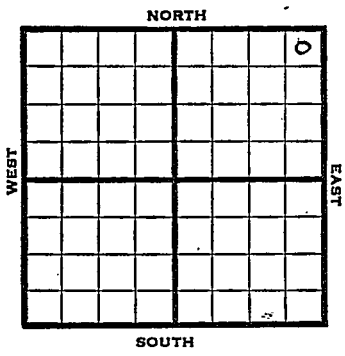

1950	Elev. 2327' REPORT
4/12	Spud 4-6-50 8" @ 158' Anhy 1830' Drlg. 2370'
5/31	8" @ 158' Heeb 3553' Arb 3944' 5" @ 3960' 422 BOPD, no wtr Grav. 20.8 TD 3962' **COMPLETED**

3944
2327
-1617

Form 26 200 Bks. 11-49 Petrol

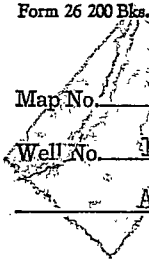

Kansas

Map No. ____ Sec. 16 Twp. 9 R. 22W

Well No. 1 Walker

Aurora Gas Company

Contractor

NE NE NE

El. 2327

SECTION PLAT



330 Ft. from N. Line

Ft. from S. Line

330 Ft. from E. Line

Ft. from W. Line

Graham County

Texas DHM

Location

Rig up

Drilling and Remarks:

Spud 4-6-50

8" @ 158

Anhy 1830

drlg. 2370

RECORD

Cased ____ in., ____ ft.

Sand

Gas

Oil

Total Depth

PRODUCTION

1st 24 hrs. Nat.

1st 24 hrs. after shot

Gas ____ Cu. Ft.

Dry Hole

Abandoned

Date

APR 12 1950 19

J. E. TYRA Scout

Wildcat

Form 26 200 Bks. 11-49 Petrol Kansas

Map No. ____ Sec. 16 Twp. 9 R. 22W


Well No. 1 Walker

Aurora Gas Company

Contractor

FE NE NE El. 2327

SECTION PLAT

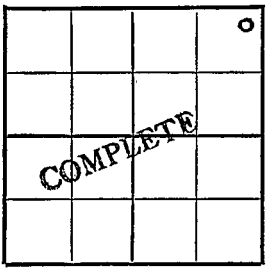

330 Ft. from N. Line

Ft. from S. Line

330 Ft. from E. Line

Ft. from W. Line

Graham

Location D&A

Rig up

Drilling and Remarks:

8"@158
Heeb-3553
K.C. 3595
Arb-3944
5"@3960
422 BOPD
+no water

RECORD

Cased ____ in., ____ ft.

Sand

Gas

Oil

Total Depth 3962

PRODUCTION

1st 24 hrs. Nat.

1st 24 hrs. after shot

Gas ____ Cu. Ft.

Dry Hole

Abandoned

Date Dr. 20.8 C

MAY 31. 1950 19 J. E. TYRA Scout