


SECTION 16 TOWNSHIP 9S RANGE 23W

WELL NO. #3 Underhill

COMPANY K & E Drlg.

NORTH C W/2 W/2 NW

4

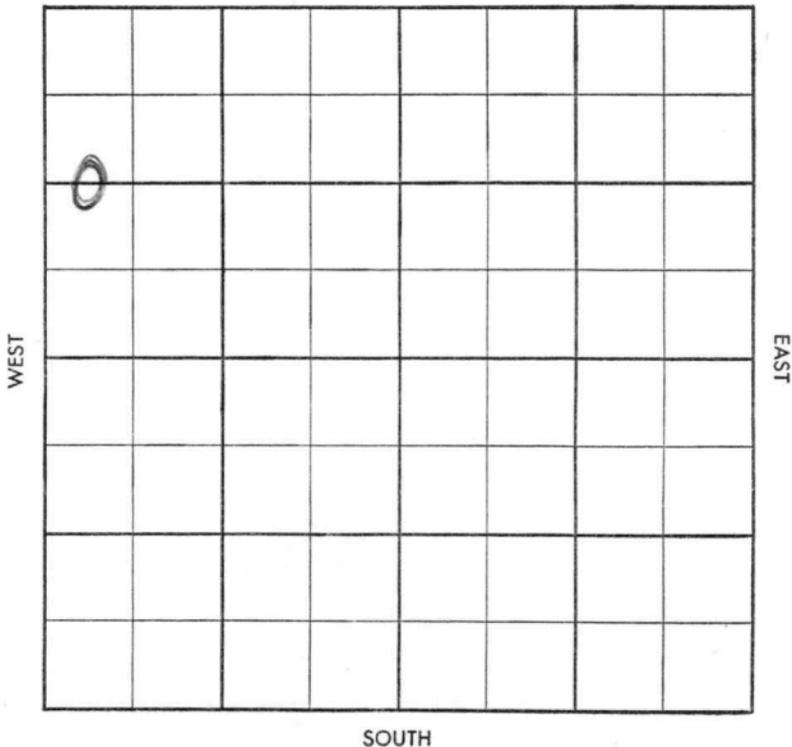



CO. Graham ELEV 23830'  
SEC. 16 TWP. 9 RGE. 23W  
COMPANY K & E Drlg. NO. 3

JAN < 1958

ABANDONED

FARM Underhill

LOC. C W $\frac{1}{2}$  W $\frac{1}{2}$  NW

A 1990
H 3687
TR 3711
L 3726
TD 3910

GEOL. \_\_\_\_\_  
CONTR. Co. tools  
POOL NW Evergreen  
SPUD 12-15-57  
M I R DEC 26 57  
JAN 2 '58 8" 250/175  
DST 3872-3910  
30" 5' M FP  
60-60 BHP 130

CO.  
LSE.  
NO.  
SEC.  
TWP.  
RGE.

D&A