


Graham

KANSAS

SECTION 16 TOWNSHIP 9S RANGE 23W

WELL NO. #1 Robinson "B"

COMPANY Imperial Drlg.

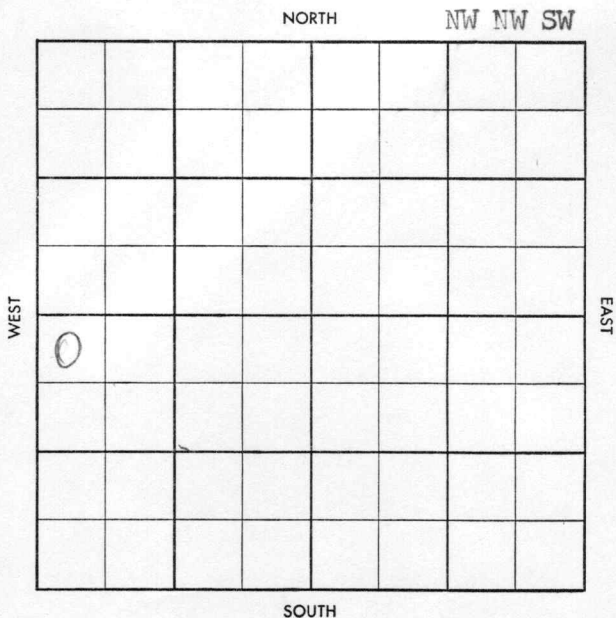


15

County Graham Elev. _____
 Sec. 16 Twp. 9 Rge. 23W
 Company Imperial Drlg.
 Farm Name Robinson "B" No. 1

TOPS	DEPTH	LOG	DATUM
Anh.	2030		
Tp.			
H.			
Tr.			
Dg.			
B.L.			
L.			
K.C.			
B.K.C.			
Ce.			
C.			
M.			
M.			
K.			
Mz.			
Mq.			
V.			
S.			
S.			
A.			
R.			
Pf.			
G.			
T.D.			

Loc. in Sec. _____
NW NW SW
 Geol. _____
 Contr. _____
Co. Tools #3
 Pool _____
Evergreen

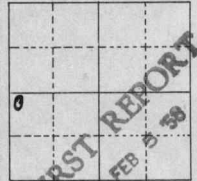

Date Comm. 2/3/58
8" @ 219 w/150, Drlg. 2480.

Co.

Lse.

No.

Sec.

T.

R.

S-513-B

County Graham Elev. 2415 KB
 Sec. 16 Twp. 9 Rge. 23W 24120F
 Company Imperial Drlg.
 Farm Name Robinson "B" No. 1

TOPS	DEPTH	LOG	DATUM
Anh.	2030		
Tp.			
H.	3703		
Tr.	3728		
Dg.			
B.L.			
L.	3741		
K.C.			
B.K.C.			
Ce.			
C.			
M.			
M.			
K.			
Mz.			
Mq.			
V.			
S.			
S.			
A.			
R.			
Pf.			
G.			
T.D.	3955		

Loc. in Sec. NW NW SW
 Geol. _____
 Contr. _____
 Co. Tools # 3
 Pool Evergreen



Date Comm. 2/3/58
8" @ 219 w/150, Drlg. 2480. FEB 12 '58 DST
3878 - 96 90" 25' M BHP
D DST 3913 - 55 FEB 19 '58
120" 50' OCM BHP 130 no log

D & A

Co.
 No.
 Sec.
 T.
 R.