


Graham

KANSAS

Section 16 Township 9 Range 24WWell No. #1 J. W. SuperCompany E. K. Carey

NORTH

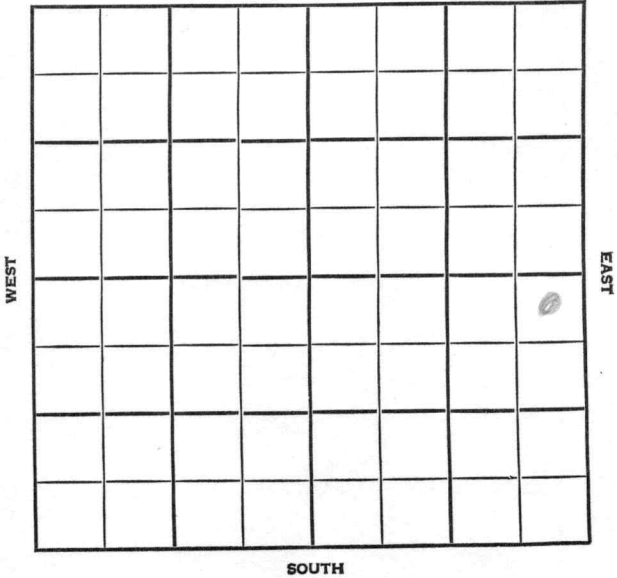

SOUTH

Graham

HOT FILE KANSAS

SEC.	TWP.	R.
16	9	24W

WELL NO.

1 J. W. Super

FARM

COMPANY

E. K. Carey

CONTRACTOR

Wildcat

330'


Ft. from N. Line

Ft. from S. Line

330'

Ft. from E. Line

Ft. from W. Line

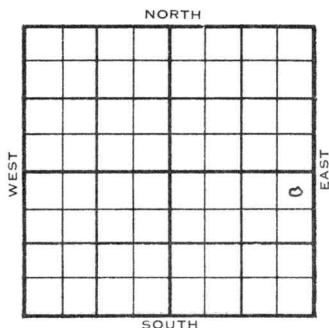

NE NE SE

NCRA-DHM

1/2 mile Sunray Mid-Continent acreage

1955

ELEVATION

2517'

REPORT

5/25

Location

6/2

Spud 5-27-55

8-5/8" @ 214 w/150

Drlg. 2880'

6/9

Anhy. 2180', Heeb 3832', Tor. 3857'

Lans. 3870',

DST 4015-55 open 1/2 hr rec 30' mud.
930/20".

Drlg. 4055'

6/15

Comm 5-27-55

8 5/8" @ 214/150

Anh 2180, H 3832 Tr 3857, L 3870,

BKC 4090, C 4384, M. Ch 4398, M Lm

4334, Base 4490, V. Ch 4502,

S. Dolo 4530, S 4581, A 4621,

TD 4640

L. 3870, C. 4366, M. ch 4402,

V 4509, S 4576, A 4589, TD 4639,

DST 4015-55 open 1/2 hr Rec 30' mud
930/20"

D&A

ABANDONED

County Graham State Kansas
Sec. 16 (Blk.) 9 (Sur.) 24W Map No.
Operator E. K. Carey
Well No. 1 Farm J. W. Super
Elev. Location NE NE SE



330 Ft. From N Line SE
330 Ft. From E Line Quarter
1st. Report MAY 2 5 1955
Completion
Remarks NCRA - DHM
Spudding Date

Drlg. Data Wildcat
Location

K-5

County Graham Elev. 2517
 Sec. 16 Twp. 9 Rge. 24W
 Company E. K. Carey
 Farm Name J. W. Super No. 1

TOPS	DEPTH	LOG	DATUM	Loc. in Sec.
Anh.	2180			NE NE SE
Tp.				
H.	3832		1315	
Tr.	3857		1340	
Dg.				Geol.
BL.				
L.	3870	3870	1353	
K.C.				
B.K.C.	4090		1573	Concr.
Ce.				
C.	4384	4366	1849	
M. ch	4398	4402	1885	
M. Lm	4334		1817	Pool
K Base	4490		1973	
Mz.				
Mq.				
V. ch	4502	4509	1992	Wildcat
S. Dolo	4530		2013	
S.	4581	4576	2059	
A	4621	4589	2072	
R.				ABANDONED
Pe.				
G.				
TD.	4640	4639		

Date Comm. 5-27-55 JUN 15 1955
8 5/8" @ 214/150 DST 4015-55 open $\frac{1}{2}$ hr

Rec. 30' mud 930/20"

D & A