


Graham

KANSAS

SECTION 16 TOWNSHIP 9S RANGE 25W

WELL NO. #1 Knoble

COMPANY Burch Drlg.

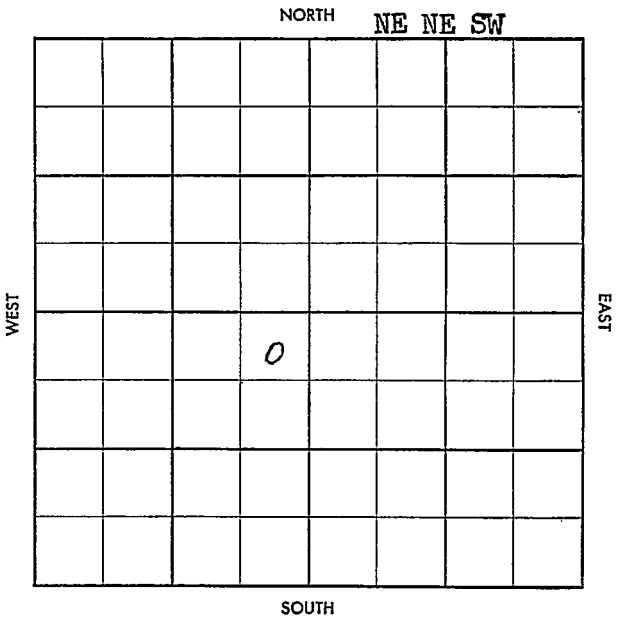

WILDCAT

S-513-B

County Graham Elev. _____
 Sec. 16 Twp. 9 Rge. 25W
 Company Burch Drlg.
 Farm Name Knoble No. 1

TOPS	DEPTH	LOG	DATUM
Anh. _____	<u>2265</u>		
Tp. _____			
H. _____			
Tr. _____			
Dg. _____			
B.L. _____			
L. _____			
K.C. _____			
B.K.C. _____			
Ce. _____			
C. _____			
M. _____			
M. _____			
K. _____			
Mz. _____			
Mq. _____			
V. _____			
S. _____			
S. _____			
A. _____			
R. _____			
Pf. _____			
G. _____			
T.D. _____			

Loc. in Sec. _____
NE NE SW
 Geol. _____
 Contr. _____
Co. Tools
 Pool _____
Wildcat

FIRST REPORT
 MAY 14 1958

Date Comm. 5/8/58 Texas - AC
8" @ 225, Drlg. 2580

Co. No. Sec. T. R.

Twp. X Pool X

Co. X Facet X

S-513-B

County Graham Elev. 2585 DF
 Sec. 16 Twp. 9 Rge. 25W
 Company Burch Drlg.
 Farm Name Knoble No. 1

TOPS	DEPTH	LOG	DATUM
Anh.	2265		
Tp.			
H.	3854		
Tr.	3877		
Dg.			
B.L.			
L.	3895		
K.C.			
B.K.C.	4121		
Ce.			
C.			
M.			
M.			
K.			
Mz.			
Mq.			
V.			
S.			
S.			
A.			
R.			
Pf.			
G.			
T.D.	4140	4137	

Loc. in Sec. NE NE SW
 Geol. _____
 Contr. _____
 Co. Tools _____
 Pool _____
Wildcat

ABANDONED
 0
 MAY 21 '58

Date Comm. 5/8/58 Texas - AC
 8" @ 225, Drlg. 2580 MAY 21 '58 DST 3920-72
 1hr 14' M BHP 880 1A log

D6A