

WICHITA BRANCH
WELL COMPLETION REPORT AND
DRILLER'S LOG

S. 6 T. 9 R. 17 ^N _W

API No. 15 — 103 — 00924-0001
County Number

Loc. SW SW SW

County _____ Rocks _____

Operator
Kenny Brown Enterprises

Address
Drawer 340 Plainville, Kansas 67663


Well No. #3 Lease Name Moos SWD OWWO

Footage Location
330 feet from (N) (S) line 330 feet from (E) (W) line

Principal Contractor Arthur Well Serv. Geologist _____

Spud Date 11-6-79 Date Completed 11-9-79 Total Depth 1505 P.B.T.D. 150

Directional Deviation _____ Oil and/or Gas Purchaser _____

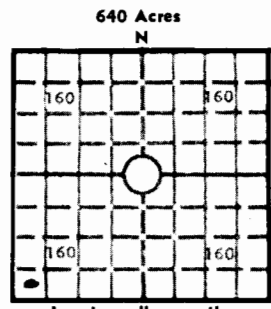

Elev.: Gr. 1995

DF _____ KB _____

CASING RECORD

Report of all strings set — surface, intermediate, production, etc.

Purpose of string	Size hole drilled	Size casing set (in O.D.)	Weight lbs/ft.	Setting depth	Type cement	Sacks	Type and percent additives
<u>Surface</u>	<u>12 1/4</u>	<u>8 5/8</u>	<u>24#</u>	<u>203</u>			
<u>Water String</u>	<u>7 7/8</u>	<u>4 1/2</u>	<u>10 1/2#</u>	<u>1408</u>	<u>Halliburton Light</u>	<u>495</u>	<u>Circulated</u>

LINER RECORD

PERFORATION RECORD

Top, ft.	Bottom, ft.	Sacks cement	Shots per ft.	Size & type	Depth interval

TUBING RECORD

Size	Setting depth	Packer set at

ACID, FRACTURE, SHOT, CEMENT SQUEEZE RECORD

Amount and kind of material used	Depth interval treated
<u>Perf. 1074' back to 974' - 1 hole every other foot for Disposal well in Cedar Hill zone</u>	

INITIAL PRODUCTION

Date of first production	Producing method (flowing, pumping, gas lift, etc.)
RATE OF PRODUCTION PER 24 HOURS	Oil Gas Water Gas-oil ratio
Disposition of gas (vented, used on lease or sold)	Producing interval (s)

INSTRUCTIONS: As provided in KCC Rule 82-2-125, within 90 days after completion of a well, one completed copy of this Drillers Log shall be transmitted to the State Geological Survey of Kansas, 4150 Monroe Street, Wichita, Kansas 67209. Copies of this form are available from the Conservation Division, State Corporation Commission, 245 No. Water, Wichita, Kansas 67202. Phone AC 316-522-2206. If confidential custody is desired, please note Rule 82-2-125. Drillers Logs will be on open file in the Oil and Gas Division, State Geological Survey of Kansas, Lawrence, Kansas 66044.

Operator <i>Kenny Brown Enterprises</i>		DESIGNATE TYPE OF COMP.: OIL, GAS, DRY HOLE, SWDW, ETC.:
Well No. <i>3 S.W.D</i>	Lease Name <i>MOE</i>	
S <i>6</i> T <i>9</i> R <i>17</i> W		

WELL LOG

Show all important zones of porosity and contents thereof; cored intervals, and all drill-stem tests, including depth interval tested, cushion used, time tool open, flowing and shut-in pressures, and recoveries.

SHOW GEOLOGICAL MARKERS, LOGS RUN, OR OTHER DESCRIPTIVE INFORMATION.

FORMATION DESCRIPTION, CONTENTS, ETC.	TOP	BOTTOM	NAME	DEPTH
<p><i>This well was washed down to a depth of 1505' for S.W.D. in Cedar Hill Sand cemented with 20 sac plug on bottom. Run 1408' of 4 1/2" - 10 1/2" casing & set @ 1408' cemented in w/ 475 sac of Halliburton Light Cement & cement circulated. Perf. Cedar Hill Sand from 1074' back to 974'. 1 hole every other ft.</i></p>				

USE ADDITIONAL SHEETS, IF NECESSARY, TO COMPLETE WELL RECORD.

Date Received	<p><i>Kenneth O. Brown</i> Signature</p> <p><i>Owner</i> Title</p> <p><i>11-27-79</i> Date</p>
---------------	--

HHHS