

KANSAS


FORM 51 IOM 12-46 PETROL

Rooks

Section 17 Township 9 Range 16-W

Well No. #2 Dorr "B"

Company Cities Service

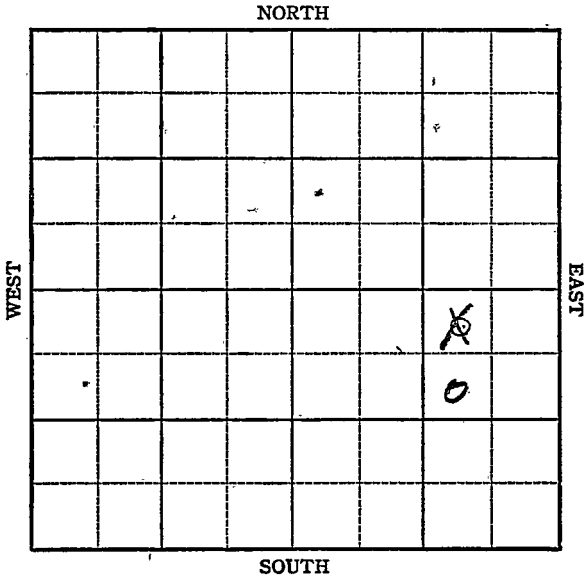

Sec. 17 Twp. 9 R. 16-W

Well No. #2 Dorr "R" Farm

Cities Service Company


Dorr Pool

990 Ft. from N. Line

_____ Ft. from S. Line

990 Ft. from E. Line

_____ Ft. from W. Line

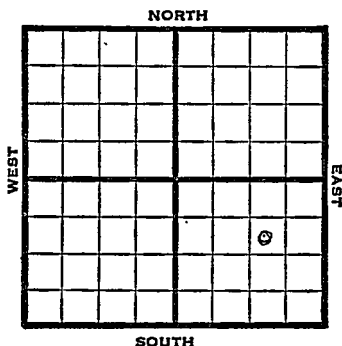

SW NE SE

REPORT	
1947	Elev. 2014
2/19	Location
2/26	Derrick
3/4	8" @ 240' Drlg 2590'
3/11	Lans 3110 TD 3348' 5" @ 3342' RUST
3/26	Lans 3110 5" @ 3342 Perf 3000 Acid Pump 206 oil & 12% water Pot Grav. 30 TD 3348'

COMPLETED

KANSAS
Kansas

Dorr Pool

Map No. 154 Sec. 17 Twp. 9 R. 16WWell No. 2 Dorr "B"

Cities Service

Company

FIRST REPORT

Contractor

SW NE SE

SECTION PLAT

990 Ft. from N. Line Ft. from S. Line990 Ft. from E. Line Ft. from W. Line

			o

Rooks County

Location XRig up

Drilling and Remarks:

RECORD

Cased in., ft.Sand Gas Oil Total Depth

PRODUCTION

1st 24 hrs. Nat. 1st 24 hrs. after shot Gas Cu. Ft.Dry Hole Abandoned

Date

FEB 1 9 1947 19

S. J. LEWIS Scout

Kansas

Map No. 1564 Sec. 17 Twp. 9 R. 16W

Well No. 2 Dorr "B"

Cities Service _____ Company

COMPLETE

Contractor

SW NE SE

EI. 2014
SECTION PLAT

990 Ft. from N. Line

_____ Ft. from S. Line

990 Ft. from E. Line

_____ Ft. from W. Line

			<i>d</i>

Rooks County

RECORD

Location _____

Cased _____ in., _____ ft.

Rig up _____

Sand _____

Drilling and Remarks:

Gas _____

Lane 3110

Oil _____

5' carbide

Total Depth *2945*

Perf.

300 acid

Pump 206 oil + 12%

PRODUCTION

1st 24 hrs. Nat. _____

1st 24 hrs. after shot _____

Gas _____ Cu. Ft.

Dry Hole _____

Abandoned _____

Date

MAR 26 1947 19

S. J. LEWIS

Scout