

KANSAS


FORM 51 10M 12-46 PETROL

Rooks

Section 17 Township 9 Range 16W

Well No. 3 Dorr "B"

Company Cities Service
Dorr

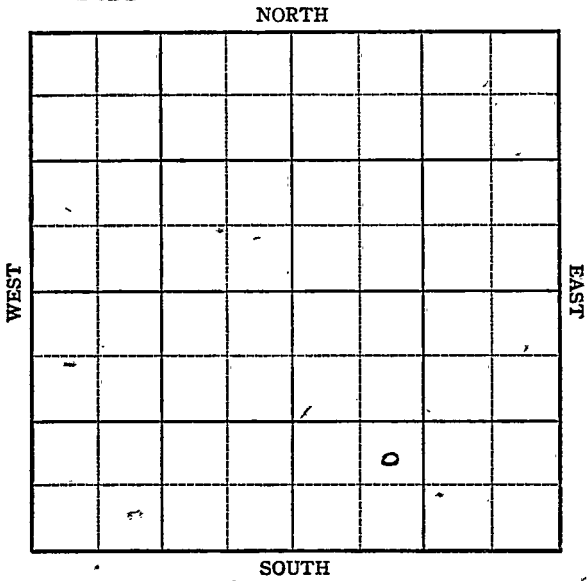

KANSAS Rooks

Sec. 17 Twp. 9 R. 16W

Well No. #3 Dorr "B" Farm

Cities Service Company

Dorr


 Ft. from N. Line

990 Ft. from S. Line

 Ft. from E. Line

990 Ft. from W. Line

NE SW SE

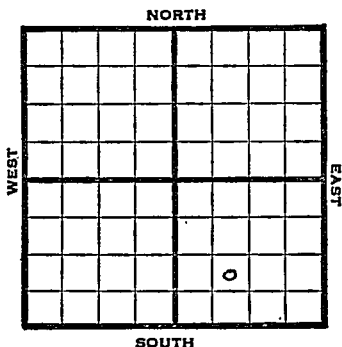

1947

Elev. 2029

REPORT

4/2 8" @ 240'
WOC

4/9 Drlg 3033'

4/15 Lansing 3130'
TD 3379'
4" @ 3379'
RUST

4/23 185 shots 3153-3352 500 acid
Pump 52 bbls oil & 7 W in 24 hrs

4/30 Lens 3130
4" @ 3379
Perf 5000 Acid -
Pump 73 oil & 11% W Pot
Grav. 33
TD 3379'

COMPLETED

Map No. K64 Sec. 17 Twp. 9 R. 16W

Well No. 3 Dorr "B"

Cities Service Company

FIRST REPORT

Contractor

NE SW SE

SECTION PLAT

 Ft. from N. Line

990 Ft. from S. Line

 Ft. from E. Line

990 Ft. from W. Line

		a	

Rooks County

Location

Rig up

Drilling and Remarks:

8" @ 240 WOC

RECORD

Cased in., ft.

Sand

Gas

Oil

Total Depth

PRODUCTION

1st 24 hrs. Nat.

1st 24 hrs. after shot

Gas Cu. Ft.

Dry Hole

Abandoned

Date

APR 2 1947 19

S. J. LEWIS Scout

