

Rooks


KANSAS

SECTION 17 TOWNSHIP 9 RANGE 16W

WELL NO. #1 R.J. Finnesy

COMPANY Bryant Oil

NORTH ~~SE~~ SE NW

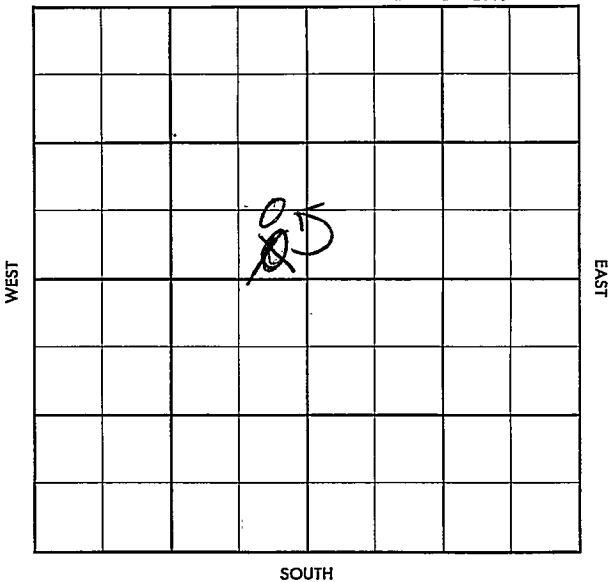

County Rooks Elev. _____
 Sec. 17 Twp. 9 Rge. 16W
 Company Bryant Oil
 Farm Name R. J. Finnesy No. 1

TOPS	DEPTH	LOG	DATUM
Anb.			
Tp.			
H.			
Tr.			
Dg.			
Bl.			
L.			
K.C.			
B.K.C.			
Ce.			
C.			
M.			
M.			
K.			
Mz.			
Mq.			
V.			
S.			
S.			
A.			
R.			
Pe.			
G.			
T.D.			

Loc. in Sec. _____
SE SE NW
 Geol. _____
 Contr. _____
Stearns Drig
 Pool _____

Dorr

FIRST REPORT

JUL 3 '57

Date Comm. Skelly - DHM

Location _____

Handwritten signature

Co.
 Lse.
 No.
 Sec.
 T.
 R.

CORRECTION

FORM 513 SUNRAY

County Rooks Elev. 2016
 Sec. 17 Twp. 9 Rge. LOW
 Company Bryant Oil
 Farm Name R. J. Finnesy No. 1

TOPS	DEPTH	LOG	DATUM	Loc. in Sec.																
Anb. <u>1248</u>		<u>1248</u>		<u>SE ST. NW</u> <u>E2</u>																
TP. <u>3095</u>	<u>3095</u>	<u>3098</u>																		
H. <u>3118</u>		<u>3118</u>																		
Tr. <u>3135</u>	<u>3135</u>	<u>3140</u>																		
Dg.				Geol.																
Bl.				Contr.																
L.				<u>Stearns Drlg</u>																
K.C.				Pool																
B.K.C.				<u>Dorr</u>																
Ce.				<table border="1"> <tr> <td></td> <td></td> <td></td> <td></td> </tr> <tr> <td></td> <td></td> <td></td> <td></td> </tr> <tr> <td></td> <td></td> <td></td> <td></td> </tr> <tr> <td></td> <td></td> <td></td> <td></td> </tr> </table>																
C.																				
M.																				
M.																				
K.																				
Mz.																				
Mo.																				
V.																				
S.																				
S.																				
A.																				
R.																				
PE.																				
G.																				
TD.	<u>3385</u>			<u>COMPLETE</u>																

Date Comm. Skelly - DHM
 Location JUL 10 '57 7-1-57 8274
212/175 M 3180 RE 17 '57 5/2 3379
JUL 24 '57 RE 31 '57 AUG 6 '57 in no drape
AUG 14 '57 DST 3223-41 (Acid tool)
CR 30" rec 75' mdy Acid wt.
BHP 70# WOCT AUG 21 '57 ✓
AUG 28 '57 SEP 4 '57 CO 3379 4/3285-89
6/3300-06 3/3320-23 5/3328
-33 6/3194-3200 6/3176-82

TB 7 G 0 + 8 G W 30" 12/31/61-65
 15/3128-23 11 8 3 Bop W
 no W 3 hrs 19 FU 1460'
 gassy cl. oil 6 hrs 9 hrs 38°
 P. 3 Bop W P. 3 L
 Bopd + 5 Bopd.

17-9-16

EV SE NW