


Section 17 Township 9 Range 18W

Well No. #1 Hilgers

Company Bay Pet.

NORTH

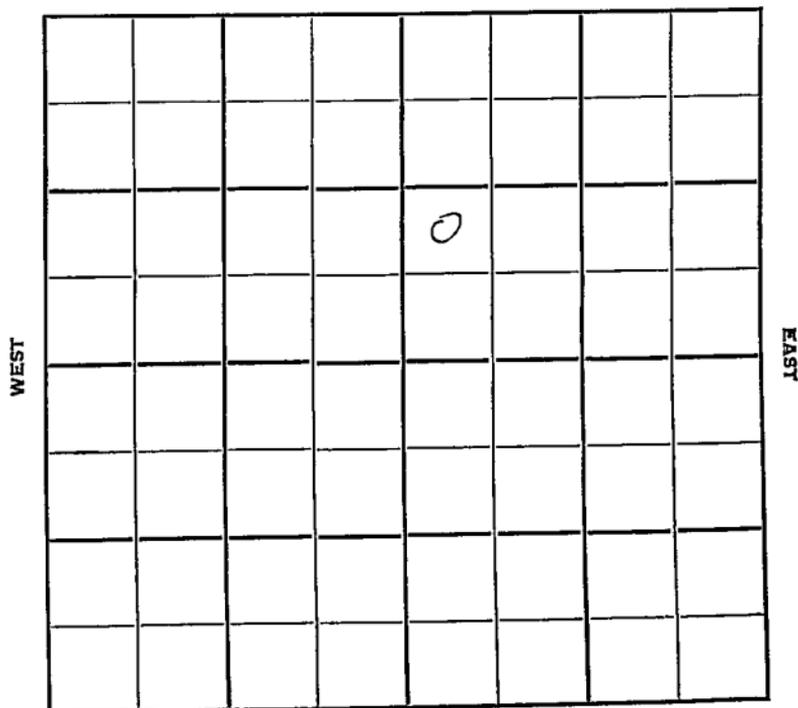

SOUTH

Sec. 17 Twp. 9 R. 18-W

Well No. #1 Hilgers Farm _____

Bay Pet. Company _____

Pickrell Drlg

McHail Pool


_____ Ft. from N. Line

990 Ft. from S. Line

_____ Ft. from E. Line

330 Ft. from W. Line

NW SW NE

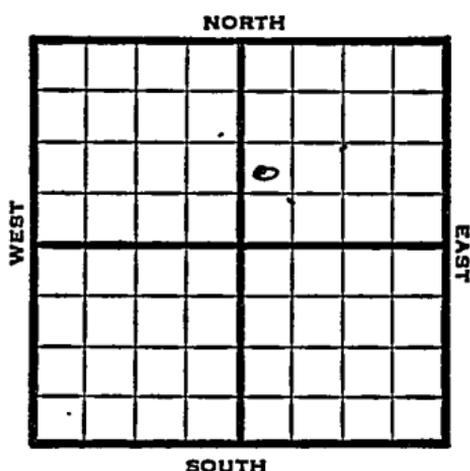

1950 Elev. - REPORT

2/22 Spud 2-17-50
8" @ 253'
Drlg 2815'

3/1 8" @ 253'
Lans 3288'
Congl 3545'
93 in Congl
D&A TD 3593'

ABANDONED

Map No. _____ Sec. 17 Twp. 9 R. 18W


Well No. 1 Hilgers

Bay Pet. _____ Company

Pickrell Drlg. _____ Contractor

NW SW NE

SECTION PLAT

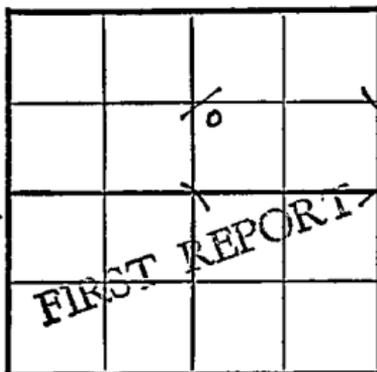

_____ Ft. from N. Line

990 _____ Ft. from S. Line

_____ Ft. from E. Line

330 _____ Ft. from W. Line

Rooks County

Location _____

Rig up _____

Drilling and Remarks:

Spud 2-17-50

8" @ 253

drlg. 2815

RECORD

Cased _____ in., _____ ft.

Sand _____

Gas _____

Oil _____

Total Depth _____

PRODUCTION

1st 24 hrs. Nat. _____

1st 24 hrs. after shot _____

Gas _____ Cu. Ft.

Dry Hole _____

Abandoned _____

Date

FEB 22 1950 19

J. E. TYRA Scout

Map No. _____ Sec. 17 Twp. 9 R. 18W

Well No. 1 Hilgers

Bay Pet. _____ Company

Contractor

NW SW NE

SECTION PLAT

_____ Ft. from N. Line

990 _____ Ft. from S. Line

_____ Ft. from E. Line

330 _____ Ft. from W. Line



Rooks County

Location _____

Rig up _____

Drilling and Remarks:

8" @ 253
 Lane 3288
 cong 3545 -
 93 in cong
 D+A

RECORD

Cased _____ in., _____ ft.

Sand _____

Gas _____

Oil _____

Total Depth 3593

PRODUCTION

1st 24 hrs. Nat. _____

1st 24 hrs. after shot _____

Gas _____ Cu. Ft.

Dry Hole _____

Abandoned _____

Date

MAR 1 1950

19

J. E. TYRA

Scout