

Section 17 Township 9 Range 18W

Well No. 1 Ruzicka

Company Petroleum Inc.

Wildcat
NORTH

WEST	9						EAST

SOUTH

Sec. 17 Twp. 9 R. 18-W ✓

Well No. #1 Ruzicka Farm
Petroleum Inc. Company

Wildcat


330 Ft. from N. Line

_____ Ft. from S. Line

_____ Ft. from E. Line

330 Ft. from W. Line

NW SW

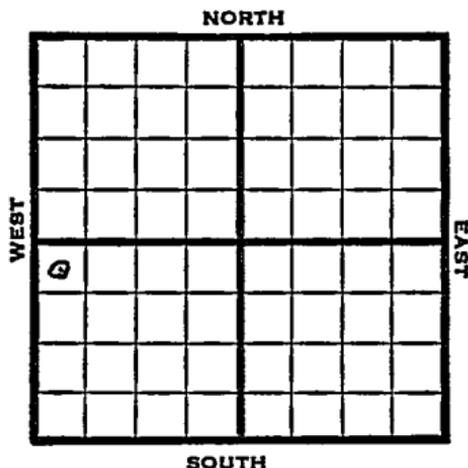

1948	Elev 2157'	REPORT
12/22	8"@ 315'	
	Drlg 1219'	
12/29	Lansing 3353	
	Drlg 3580'	
1949		
1/12	TD 3619'	
	Lansing 3368'	
	Arb 3614'	
	5 "@ 3615'	
	Pump 50 oil / W Pot	
	28 ⁶ Gr.	
	Comp	
	COMPLETED	

Map No. _____ Sec. 17 Twp. 9 R. 18W

Well No. 1 Ruzicka

Petroleum Inc. _____ Company

FIRST REPORT _____ Contractor

NW SW

SECTION PLAT

330 Ft. from N. Line

_____ Ft. from S. Line

_____ Ft. from E. Line

330 Ft. from W. Line

6			

Rooks County

RECORD

Location _____

Cased _____ in., _____ ft.

Rig up _____

Sand _____

Drilling and Remarks:

Gas _____

8" @ 315

Oil _____

drlg. 1219

Total Depth _____

PRODUCTION

1st 24 hrs. Nat. _____

1st 24 hrs. after shot _____

Gas _____ Cu. Ft.

Dry Hole _____

Abandoned _____

Date

DEC 22 1948 19

S. J. LEWIS Scout

Kansas

Map No. 64 Sec. 17 Twp. 9 R. 18WWell No. 1 Ruzicka

Petroleum Inc.

Company

COMPLETE


Contractor

NW SW

E12175
SECTION PLAT330 Ft. from N. Line

Ft. from S. Line

Ft. from E. Line

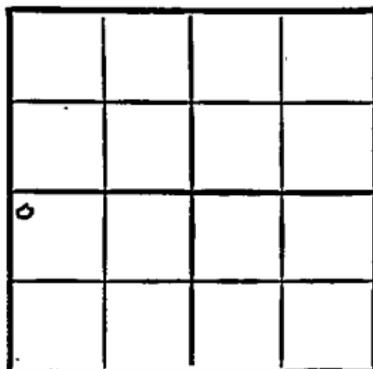330 Ft. from W. Line

Rooks County

RECORD

Location

Cased _____ in., _____ ft.

Rig up

Sand _____

Drilling and Remarks:

Gas _____

Oil ✓Total Depth 3619

PRODUCTION

1st 24 hrs. Nat. _____

1st 24 hrs. after shot _____

Gas _____ Cu. Ft.

Dry Hole _____

Abandoned _____

Date

JAN 12 1949 19S. J. LEWIS

Scout