

Section 17 Township 9 Range 18W

Well No. I. W. Stahl

Company Sinclair-Prairie

McHale Pool

NORTH

			0				

WEST

EAST

SOUTH



Sec. 17 Twp. 9 R. 18W

Well No. 1 W. Stahl Farm

Sinclair-Prairie Company

McHale Pool


330 Ft. from N. Line

\_\_\_\_\_ Ft. from S. Line

330 Ft. from E. Line

\_\_\_\_\_ Ft. from W. Line

NE NW

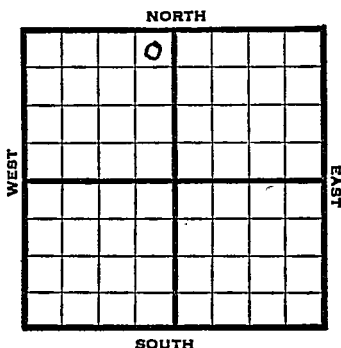

1948

Eli 2074'

REPORT

9/22

Location

9 29

8" @ 276'

Drlg 1235'

10/6

Drlg 3420'

10/13

Lansing 3250'

Arb 3502'

TD 3511

5" @ 3502 1000 acid

10/19

Simpson Dolo 3502'

Arb. 3506'

TD 3511

PB 3504 1000 acid

Swb 25 bbls oil PH 6 hrs.

10/27

TD 3511'

Arb. 3506'

5" @ 3502

1000 acid

Pump 838 Pot

31° Gr.

Gomp

**COMPLETED**

Rooks County Kansas State

Map No. \_\_\_\_\_ Sec. 17 Twp. 9 R. 18W

Well No. 1 W. Stahl

Sinclair-Prairie Company

**FIRST REPORT**

Contractor

NE NW

**SECTION PLAT**


330 Ft. from N. Line

\_\_\_\_\_ Ft. from S. Line

330 Ft. from E. Line

\_\_\_\_\_ Ft. from W. Line

McHale Pool

Remarks:

Location

Date  
SEP 22 1948

Scout  
S. J. LEWIS

Map No. 64 Sec. 17 Twp. 9 R. 18W

Well No. 1 W. Stahl

Sinclair-Prairie Company

**COMPLETE**

Contractor

NE NW

*E1.2074*  
**SECTION PLAT**

330 Ft. from N. Line

\_\_\_\_\_ Ft. from S. Line

330 Ft. from E. Line

\_\_\_\_\_ Ft. from W. Line

	0		

Rooks County

**RECORD**

Location \_\_\_\_\_

Cased \_\_\_\_\_ in., \_\_\_\_\_ ft.

Rig up \_\_\_\_\_

Sand \_\_\_\_\_

Drilling and Remarks:

Gas \_\_\_\_\_

*Cr 13506*

Oil

*5" @ 3502.*

Total Depth 11357

*1000 acid*

*Pump 13808*

**PRODUCTION**

1st 24 hrs. Nat. \_\_\_\_\_

1st 24 hrs. after shot \_\_\_\_\_

Gas \_\_\_\_\_ Cu. Ft.

Dry Hole \_\_\_\_\_

Abandoned \_\_\_\_\_

*3108*

Date

OCT 27 1948

19

S. J. LEWIS

Scout