

KANSAS

Rooks


Section 17 Township 9 Range 18W

Well No. 1 Stahl

Company North American Prod.

McHale

NORTH

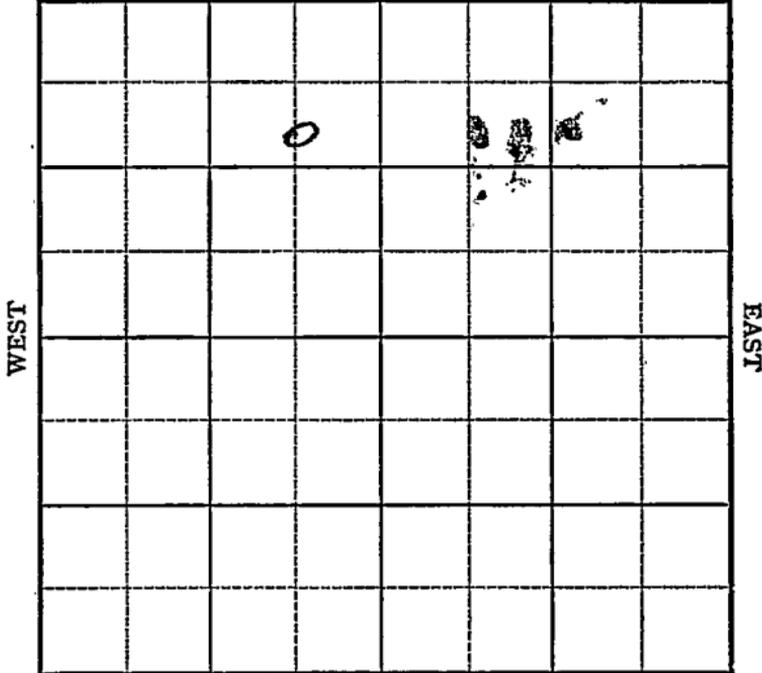

SOUTH

Rooks

KANSAS

Sec. 17 Twp. 9 R. 18W

Well No. #1 Stahl Farm


North American Prod.

Company

McHale Pool (Harbor, Cont.)

NORTH

990' Ft. from N. Line

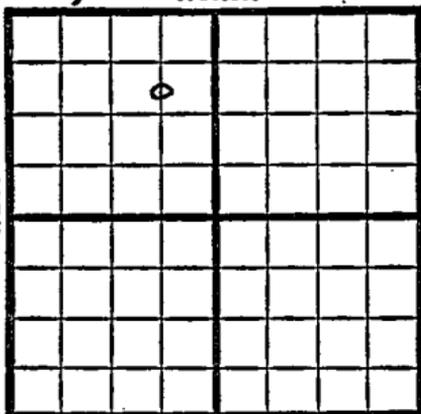

_____ Ft. from S-Line

660' Ft. from E. Line

_____ Ft. from W. Line

C S L NE NW

SOUTH

1949 Elev. 2094' REPORT

8/3 8" @ 252'
Anhy 1460'
Drlg. 2180'

8/10 Lansing 3280'
Drlg 3415'

8/17 Arb. 3520-
5" @ 3520'
TD 3524'
570' oil 1 1/4 hrs.

8/24 TD 3527'
Sw & 9 bbl oil PH 4 hrs.

8/31 250 acid
Pump 58 bbls oil 3 hrs.

9/7 Arb 3520'
5" @ 3520'
250 acid
Echo Pot. 2000 oil
Grav. 27°
TD 3527'

COMPLETED

Kansas

McHale Pool

Map No. _____ Sec. 17 Twp. 9 R. 10W

Well No. 1 Stahl

North American Prod. Company

Harbor

Contractor

C S L NE NW


FIRST REPORT
SECTION PLAT

990 Ft. from N. Line

_____ Ft. from S. Line

660 Ft. from E. Line

_____ Ft. from W. Line

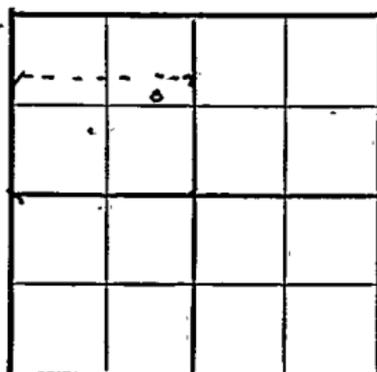

Rooks County

Location _____

Rig up _____

Drilling and Remarks:

8" @ 252

anhy 1460

2180

RECORD

Cased _____ in., _____ ft.

Sand _____

Gas _____

Oil _____

Total Depth _____

PRODUCTION

1st 24 hrs. Nat. _____

1st 24 hrs. after shot _____

Gas _____ Cu. Ft.

Dry Hole _____

Abandoned _____

Date

AUG 3 1949 19

S. J. LEWIS Scout

Map No. K64 Sec. 17 Twp. 9 R. 18W

Well No. 1 Stahl

North American Prod. Company

COMPLETE

Contractor

C S L NE NW

E12094
SECTION PLAT

	o		

990 Ft. from N. Line

_____ Ft. from S. Line

660 Ft. from E. Line

_____ Ft. from W. Line

Rooks County

Location _____

Rig up _____

Drilling and Remarks:

Cu 20520
5" C 3520
2500 acid
Ech 2000 out
27 250

RECORD

Cased _____ in., _____ ft.

Sand _____

Gas _____

Oil _____

Total Depth 2527

PRODUCTION

1st 24 hrs. Nat. _____

1st 24 hrs. after shot _____

Gas _____ Cu. Ft.

Dry Hole _____

Abandoned _____

Date

SEP 7 1949 19

S. J. LEWIS Scout