

KANSAS


Rocks

Section 17 Township 9 Range 18W

Well No. 2 Stahl

Company Harbar Drlg.

McHale
NORTH

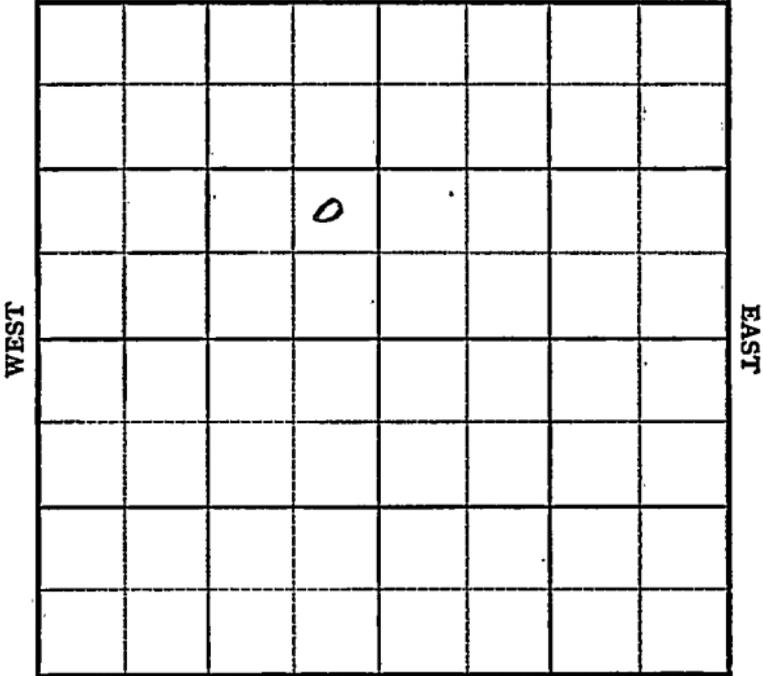

SOUTH

Sec. 17 Twp. 9 R. 18W

Well No. #2 Stahl Farm

Harbar Drlg. Company


McHale Pool (Harber Drlg., Cont. NORTH)

_____ Ft. from N. Line

990' Ft. from S. Line

330' Ft. from E. Line

_____ Ft. from W. Line

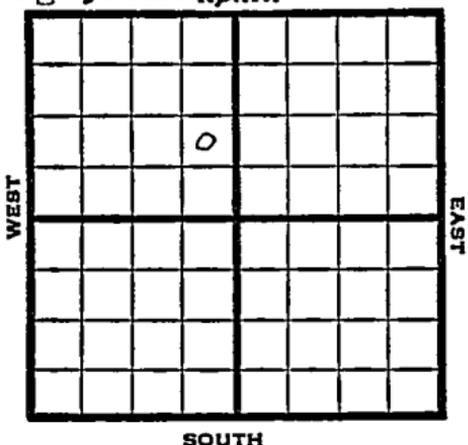

NE SE NW

1949 Elev. 2098 REPORT

9/7 8" @ 250'
 Anhy 1455'
 Drlg. 2280'

9/14 Lansing 3074'
 Drlg 3528'

9/21 Lans. 3274'
 Arbuckle 3525'
 TD 3532'
 5" @ 3527'

10/5 Arb. 3525'
 5" @ 3527'
 250 acid
 Echo Pot 3000
 TD 3532' 3100' oil 10 hrs.
 Grav. 29°
 Comp.

COMPLETED

Map No. _____ Sec. 17 Twp. 9 R. 18W

Well No. 2 Stahl

_____ Harbar Drlg. _____ Company

_____ Harbar Drlg. _____ Contractor

NE SE NW

FIRST SECTION PLAT

_____ Ft. from N. Line

990 Ft. from S. Line

330 Ft. from E. Line

_____ Ft. from W. Line

Rooks County

Location _____

Rig up _____

Drilling and Remarks: _____

8" @ 250

Anhy 1455

drlg. 2280

RECORD

Cased _____ in., _____ ft.

Sand _____

Gas _____

Oil _____

Total Depth _____

PRODUCTION

1st 24 hrs. Nat. _____

1st 24 hrs. after shot _____

Gas _____ Cu. Ft.

Dry Hole _____

Abandoned _____

Date _____

SEP 7 1949 19

S. J. LEWIS Scout

Kansas

Map No. _____ Sec. 17 Twp. 9 R. 18W

Well No. 2 Stahl

Harbar Drlg.

Company

COMPLETE

Contractor

NE SE NW

E 12098
SECTION PLAT

_____ Ft. from N. Line

990 Ft. from S. Line

330 Ft. from E. Line

_____ Ft. from W. Line

	o		

Rooks County

Location _____

Rig up _____

Drilling and Remarks:

*Ar 83525**5" @ 3527**2500 acid**Ech 1100 @ 3000**295 lb*

RECORD

Cased _____ in., _____ ft.

Sand _____

Gas _____

Oil _____

Total Depth *3522*

PRODUCTION

1st 24 hrs. Nat. _____

1st 24 hrs. after shot _____

Gas _____ Cu. Ft.

Dry Hole _____

Abandoned _____

Date

OCT 5 1949

19

S. J. LEWIS

Scout