

Section 17 Township 9S Range 18W

Well No. 2 Stahl

Company Sinclair-Prairie

Westhusin

NORTH

	6						

WEST

EAST

SOUTH

KANSAS Rooks

Sec. 17 Twp. 9 R. 18W

Well No. #2 Stahl Farm

Sinclair-Prairie Company

Westhusin


330' Ft. from N. Line

Ft. from S. Line

Ft. from E. Line

990' Ft. from W. Line

NE NW NW

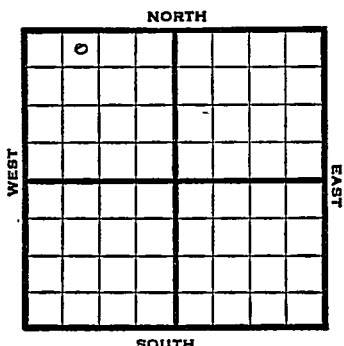

1949

Eleb 2110

R E P O R T

2/9 RUR

2/16 10"@ 315'

Drlg 2340'

2/23 3639 fsg.

3/2 Lansing 3298'

Simpson 3544'

Arb. 3550'

TD 3652'

7"@ 3652'

3/8 "

3/16 TD 3652'

Arb. 3550'

7"@ 3652

Perf 1000 acid

Pump 446 oil / 26% W Pot.

37° Gr.

Comp

COMPLETED

Kansas

*Westhursin*Map No. _____ Sec. *17* Twp. *9* R. *18 W*Well No. *2 Stahl**Sinclair-Prairie* Company

FIRST REPORT

NE NW NW Contractor

SECTION PLAT

330 Ft. from N. Line

_____ Ft. from S. Line

_____ Ft. from E. Line

990 Ft. from W. Line

<i>0</i>			

Roopa

Location _____

Rig up _____

Drilling and Remarks:

RUR

RECORD

Cased _____ in., _____ ft.

Sand _____

Gas _____

Oil _____

Total Depth _____

PRODUCTION

1st 24 hrs. Nat. _____

1st 24 hrs. after shot _____

Gas _____ Cu. Ft.

Dry Hole _____

Abandoned _____

Date

FEB 9 1949

19

S. J. LEWIS

Scout

Map No. K64 Sec. 17 Twp. 9 R. 18W

Well No. 2 Stahl

Sinclair-Prairie Company

COMPLETE

NE NW NW

Contractor

E12110


SECTION PLAT

330 Ft. from N. Line

Ft. from S. Line

Ft. from E. Line

990 Ft. from W. Line

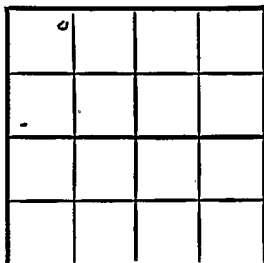

Rooks County

Location

Rig up

Drilling and Remarks:

Cor 13558

7" 29652

*Perf.
1000 acid*

Prod 446 oil + 269 gas

*25X.
37 1/2*

RECORD

Cased _____ in., _____ ft.

Sand _____

Gas _____

Oil _____

Total Depth 3652

PRODUCTION

1st 24 hrs. Nat. _____

1st 24 hrs. after shot _____

Gas _____ Cu. Ft.

Dry Hole _____

Abandoned _____

Date

MAR 16 1949

19

S. J. LEWIS

Scout