

# KANSAS


Rooks

FORM 51 25M 3-49 PETROL

Section 17 Township 9S Range 18W

Well No. #3 Stahl

Company Harbar

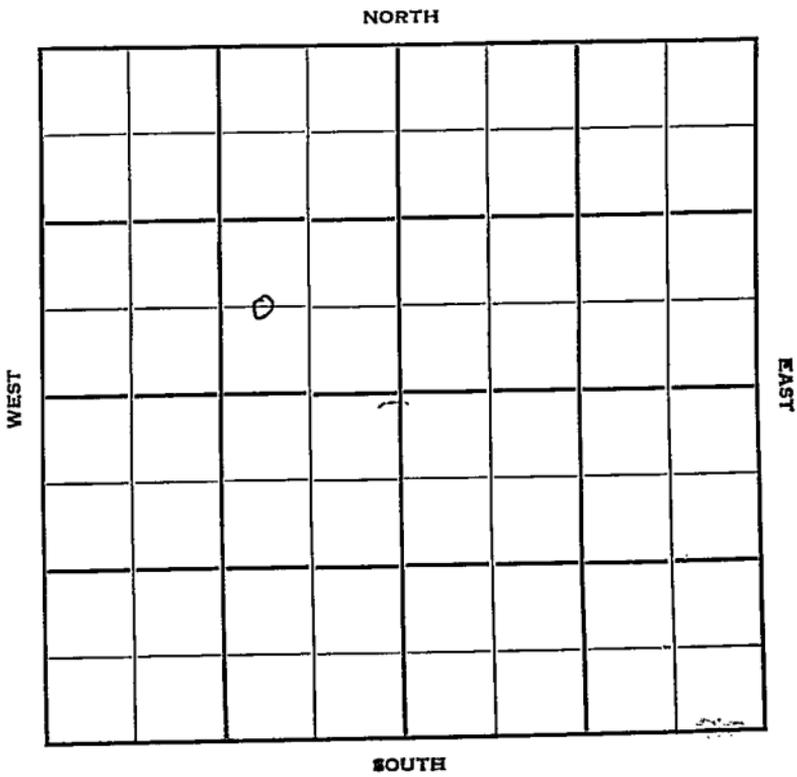

Sec. 17 Twp. 9 R. 18-W

Well No. #3 Stahl Farm \_\_\_\_\_  
Harbar Company \_\_\_\_\_


**Harbar**

\_\_\_\_\_ Ft. from N. Line

660 Ft. from S. Line

990 Ft. from E. Line

\_\_\_\_\_ Ft. from W. Line

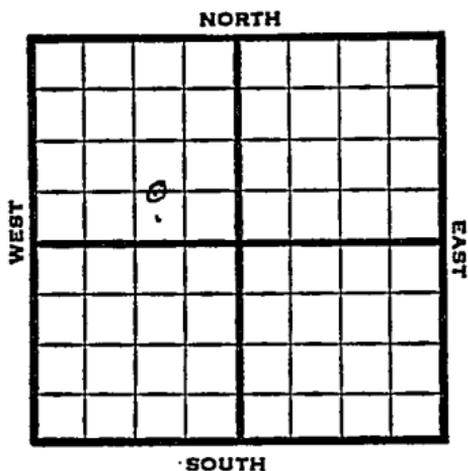

C W L SE, NW

1949 Elev. 2110' REPORT

- 10/12 10" @ 240'  
Anhy 1495'  
Drlg 2337'
- 10/19 TD 3543'  
5" @ 3541'
- 10/26 Arbuckle 3539'  
TD 3541'  
5" @ 3539'
- 11/1 Lansing 3289'  
Swb 40 bbls oil PH, 3 hrs.
- 11/9 TD 3541'
- 11/16 TD 3541'  
Arb. 3539'  
5" @ 3539'  
Depth Pot 3000  
27° Gr.  
Comp

**COMPLETED**

Map No. \_\_\_\_\_ Sec. 17 Twp. 9 R. 18W

Well No. 3 Stahl

Harbar \_\_\_\_\_ Company

Harbar \_\_\_\_\_ Contractor

C W L SE NW

FIRST REPORT  
SECTION PLAT

	o		

\_\_\_\_\_ Ft. from N. Line

660 \_\_\_\_\_ Ft. from S. Line

990 \_\_\_\_\_ Ft. from E. Line

\_\_\_\_\_ Ft. from W. Line

Rooks County

Location \_\_\_\_\_

Rig up \_\_\_\_\_

Drilling and Remarks:

10" @ 240

Anhy 1495

drlg. 2337

RECORD

Cased \_\_\_\_\_ in., \_\_\_\_\_ ft.

Sand \_\_\_\_\_

Gas \_\_\_\_\_

Oil \_\_\_\_\_

Total Depth \_\_\_\_\_

PRODUCTION

1st 24 hrs. Nat. \_\_\_\_\_

1st 24 hrs. after shot \_\_\_\_\_

Gas \_\_\_\_\_ Cu. Ft.

Dry Hole \_\_\_\_\_

Abandoned \_\_\_\_\_

Date

OCT 12 1949 19

S. J. LEWIS Scout

Map No. \_\_\_\_\_ Sec. 17 Twp. 9 R. 18W

Well No. 3 Stahl

Harbar \_\_\_\_\_ Company

COMPLETE \_\_\_\_\_ Contractor

C W L SE NW

E1, 2110  
SECTION PLAT

\_\_\_\_\_ Ft. from N. Line

660 Ft. from S. Line

990 Ft. from E. Line

\_\_\_\_\_ Ft. from W. Line

	6		

Rooks County

Location \_\_\_\_\_

Rig up \_\_\_\_\_

Drilling and Remarks:

*Core 3539*

*5" C 3539*

*Depth Pay 3000*

*270 ft*

RECORD

Cased \_\_\_\_\_ in., \_\_\_\_\_ ft.

Sand \_\_\_\_\_

Gas \_\_\_\_\_

Oil \_\_\_\_\_

Total Depth 3541

PRODUCTION

1st 24 hrs. Nat. \_\_\_\_\_

1st 24 hrs. after shot \_\_\_\_\_

Gas \_\_\_\_\_ Cu. Ft.

Dry Hole \_\_\_\_\_

Abandoned \_\_\_\_\_

Date

NOV 16 1949

19

S. J. LEWIS Scout