

Section 17 Township 9 Range 20WWell No. 1 PfannenstielCompany Anderson-Prichard

NORTH

WEST

EAST

SOUTH

(S)

0

Rooks KANSAS



Sec. 17 Twp. 9 R. 20 W

Well No. # 1 Pfannenstiel Farm

Anderson-Prichard Company

Transit Contractor

Gra-Rook Pool


Ft. from N. Line

330 Ft. from S. Line

Ft. from E. Line

990 Ft. from W. Line

SE SW SE

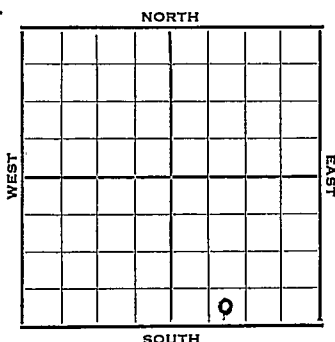

1953 Elev. 2245' REPORT

4/8 Spud 4-5-53
8" @ 554 Anhy 1740'
Drlg. 2203'

4/16 Top 3270, Heeb 3482, Tor 3503, Lans 3519
Drlg. 3665'

4/22 Spud -4-5-53 D & A TD 3887
8" @ 554 Anhy 1740 Top 3270
Heeb 3482 Tor 3503 Lans 3519
B. Lans 3741 Cong. 3791 Arb. 3875
TD 3887 D & A

ABANDONED

County _____ Books _____ State **Kansas**

Sec. 17 (Blk. Twp.) 9 (Sur. Rge.) 20W Map No.

Operator Anderson-Prichard

Well No. 1 Farm Pfannenstiel

Elev. 2245 Location SE SW SE

FIRST REPORT

330 Ft. From S Line SE

990 Ft. From W Line Quarter

1st. Report APR 8 1953

Completion

Remarks


Transit - Contr.

Spudding Date **4-5-53**

Drig. Data Gra-Rook Pool

8" @ 554 Anhy 1740 drlg. 2203

J. G. McGEHEE

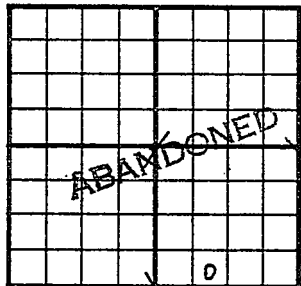County Rooks State KansasSec. 17 (Blk.
Twp.) 9 (Sur.
Rge.) 20W Map No.Operator Anderson-PrichardWell No. 1 Farm PfannenstielElev. 2245 Location SE SW SE330 Ft. From S Line SE990 Ft. From W Line Quarter1st. ReportCompletion APR 22 1953Remarks Gra-Rook PoolTransit Drlg. - Contr.Spudding Date 4-5-53 -Drlg. Data D & A TD 38878" @ 554 Anhy 1740 Top. 3270Heeb. 3482 Tor. 3503 Lans. 3510B. Lens. 3741 Cong. 3791 Arb. 3875TD 3887D & A