


Section 17 Township 9 Range 26W

Well No. 3 Mills

Company G M R Oil

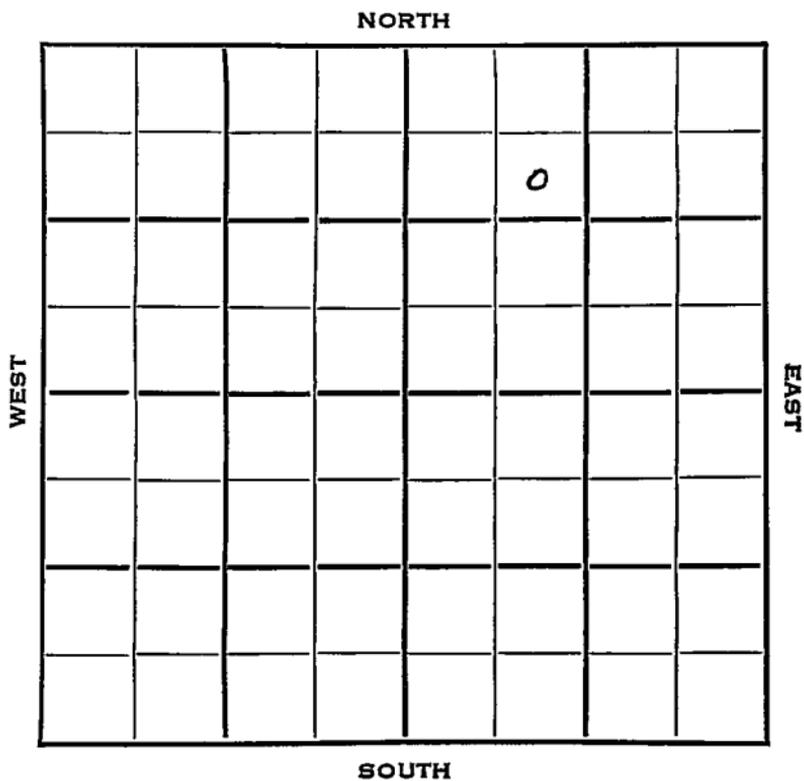

Sheridan **KANSAS**

Sec. 17 Twp. 9 R. 26W

Well No. #3 Mills Farm _____

G-M-R Oil Company _____

Contractor George Pool


990 Ft. from N. Line

_____ Ft. from S. Line

_____ Ft. from E. Line

990 Ft. from W. Line

SE NW NE

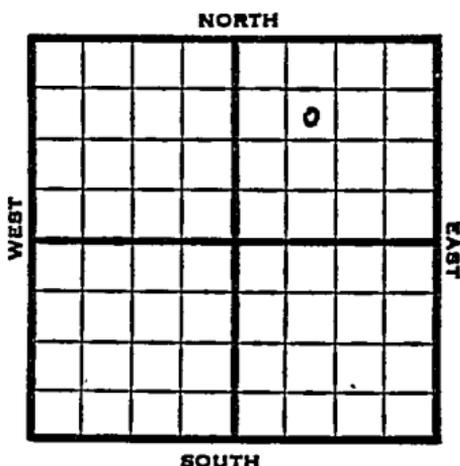

1953 Elev. 2687' REPORT

1/21 Location

1/29 8" @ 305
Drlg. 3642'

2/5 Heeb 3782' Tor. 3801'
DST 3802-15, 1 hr, 75' wtr. 1100#
Lans. 3820'
DST 3896-3922, 1 hr, 160' wtr 1250#
DST 3990-4030, RTD 1 hr. 10' M O#
5" @ 4025'

2/12 18/4012-18 15/4023-28 3000 A
S/1 1/2 BOPH 5000 A

2/19 D & A

2/25 Spud 1-21-53 D & A TD 4030
8" @ 305 Heeb 3782 Tor 3801
DST 3802-15 open 1 hr. rec 75' wtr.
1100#
Lans 3820
DST 3896-3922 open 1 hr. rec 160' Wtr.
1250#
DST 3990-4030 open 1 hr. rec 10' mud O#
5" @ 4025 18/4012-18 15/4023-28
3000 A S/1 1/2 BOPH 5000 A oil dec.
D & A

ABANDONED

County Sheridan State Kansas

Sec. 17 (Blk. 9 (Sur. 26W (Twp.) 9 (Rge.) 26W Map No.

Operator G-M-R Oil

Well No. 3 Farm Mills

Elev. _____ Location SE NW NE

			0		

990 Ft. From N Line NE

990 Ft. From W Line Quarter

1st. Report JAN 21 1953

Completion _____

Remarks _____

Spudding Date _____

Drlg. Data George Pool

Location

