KANSAS


FORM 51 25M 3-49 PETROL

Sheridan

Section 17 Township 9 Range 26W

Well No. 1 Richards

Company G M R Oil

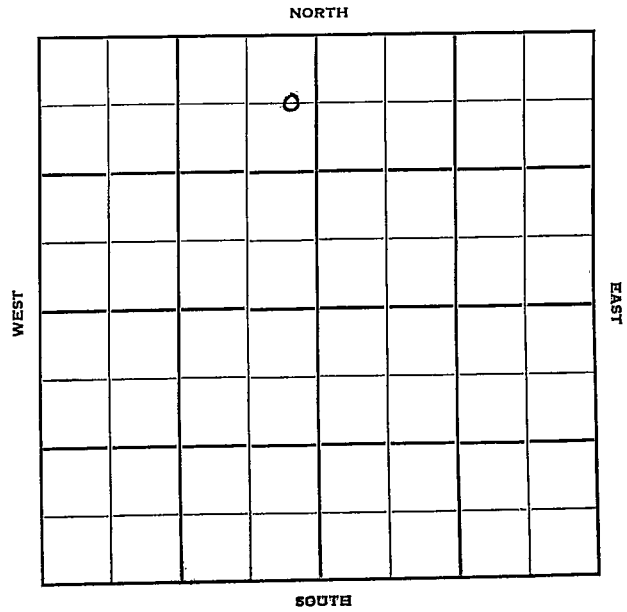

FORM 252-B

Sheridan KANSAS ✓

Sec. 17 Twp. 9 R. 26 W

Well No. # 1 Richards Farm

G-M-R Oil Company

Contractor

George Pool


660 Ft. from N. Line

Ft. from S. Line

330 Ft. from E. Line

Ft. from W. Line

C E L NE NW

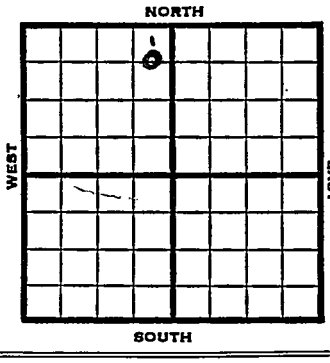

1952	Elev. 2701' REPORT
12/17	RUR
12/18	RUR
12/25	RUR
1/1	Heeb 3797 TOR 3818 Lans 3836-73 1 hr. 840' SW DST 4000-4010 1 hr. 60' Oil 1350# DS 4022-50
1/8	1 Hr. 1320' Gas 190' GCO RTD 4050 5" Set.
1/15	5"@ 4050, CO to 4045 21/4002-07, 1000A S/20 BOPH, 48/4020-32, S/23 BOPH for 6 hrs., POP
1/22	NR
1/29	"
2/4	Spud 12-15-52 Oil well TD 4050' 8" @ 304 Heeb 3797' Tor. 3818' Lans. 3836' DST 3838-73 open 1 hr. rec 840' SW DST 4000-10 open 1 hr. rec 60' oil 1350# DST 4022-50 open 1 hr. rec 1320' gas, 690' GCO TD 4050' 5" @ 4050 CO to 4045' 21/4002-07 1000 A

OVER

1953
2/6 S/20 BOPH 6 hr. 48/4020-32
S/23 BOPH 6 hr.
Comp. 379 BOPD

COMPLETED

FORM 275 FOR SALE BY KANSAS BLUE PRINT CO


County Sheridan State Kansas

Sec. 17 (Blk. / Twp.) 9 (Sur. / Rge.) 26W Map No.

Operator G-M-R Oil

Well No. 1 Farm Richards

Elev. Location C EL NE NW

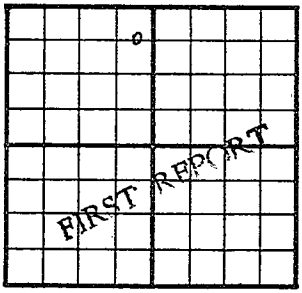

660 Ft. From N Line NW

330 Ft. From E Line Quarter

1st. Report DEC 17 1952

Completion

Remarks

Spudding Date

Drlg. Data George Pool

R U R

J. G. McGEHEE

FORM 275 FOR SALE BY KANSAS BLUE PRINT CO.


County Sheridan State Kansas

Sec. 17 (Blk. Twp.) 9 (Sur. Rge.) 26W Map No.

Operator G-M-R Oil

Well No. 1 Farm Richards

Elev. 2701 Location C E L NE NW

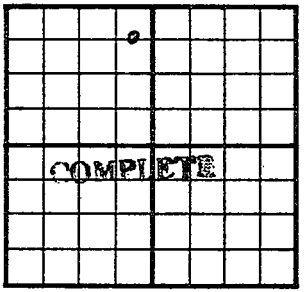

660 Ft. From N Line NW

330 Ft. From E Line Quarter

1st. Report

Completion FEB 4 1953

Remarks George Pool

Spudding Date 12-15-52

Drlg. Data Oil well TD 4050

8" @ 304 Heeb. 3797 Tor. 3818

Lans. 3836 DST 3838-73 open 1 hr.

Rec. 840' sw DST 4000-10 open 1 hr.

Rec. 60' oil 1350# DST 4022-50.

open 1 hr. Rec. 1320' gas 690' gco

TD 4050 5" @ 4050 CO to 4045 21/ 4002-

07 1000 A S/ 20 boph 6 hr. 48/ 4020-

32 S/ 23 boph 6 hr.

Comp. 379 bopd

J. G. McGEHEE