

Sheridan

KANSAS

17

9

26W

SECTION

TOWNSHIP

RANGE

#2 Richards

WELL NO.

COMPANY


Sauvage

NORTH

W 2 SE
C S 1/2 NE NW

WEST

EAST

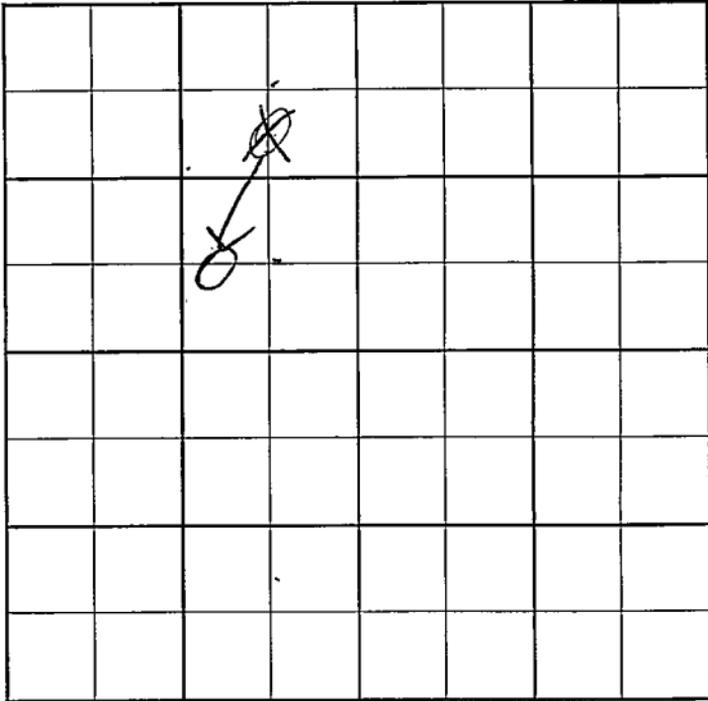

SOUTH

County Sheridan Elev. _____
 Sec. 17 Twp. 9 Rgs. 26W
 Company Sauvage
 Farm Name Richards No. 2

TOPS	DEPTH	LOG	DATUM
Anh.			
Tp.			
H.			
Tr.			
Dg.			
Bl.			
L.			
K.C.			
B.K.C.			
Ce.			
C.			
M.			
M.			
K.			
Mz.			
Mo.			
V.			
S.			
S.			
A.			
R.			
PE.			
G.			
T.D.			

Loc. in Sec. G S/2 NE NW

Geol. _____

Contr. _____

Pool

George

FIRST REPORT

MAY 29 '57

Date Comm. 5-25-57
8" @ 310, Drlg 1700

33

Co.

Loc.

No.

Sec.

T.

R.

CORRECTION

FORM 513 SUNRAY

County Sheridan Elev. 2708

Sec. 17 Twp. 9 Rge. 26W

Company Sauvare

FarmName Richards No. 2

TOPS	DEPTH	LOG	DATUM	Loc. in Sec.
Anb.				G-8/2 NE 1/4 W2 SE
TP.				
H.	3808			
Tr.				
Dg.				
Bl.				
L.	3847			Geol. _____
K.C.				Contr. _____
B.K.C.	4051			
Ce.				
C.				
M.				Pool
M.				George
K.				
Mz.				
Ma.				
V.				
S.				
S.				
A.				
R.				
PE.				
G.				
TD.	4060			ABANDONED

Date Comm. 5-25-57

8" @ 310, Drlg 1700 JUN 5 '57 need a

~~DT~~ JUN 19 '57 ✓ JUN 26 '57 DST 3871-89

1hr 20' 50CM BHP 1100 DST 3918

-38 1hr 390' 50CM E'W BHP 1000

DST 3969-4000 of 1hr run 38'

Md BHP 0 DST 3999-4060 of

1hr run 15' Md BHP 0

D.E.A. ~~(Signature)~~