

KANSAS

FORM 51 IOM 12-46 PETROL

Rooks

Section 18 Township 9 Range 16-WWell No. 1 BellCompany Cities Service

Wildcat

NORTH

WEST

EAST

							0

SOUTH

KANSAS Rooks

Sec. 18 Twp. 9 R. 16W

Well No. #1 Bell Farm

Cities Service Company

Wildcat


 Ft. from N. Line

330 Ft. from S. Line

330 Ft. from E. Line

 Ft. from W. Line

SE/c

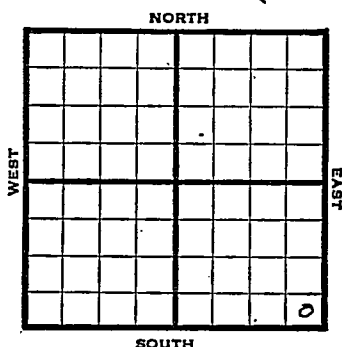

1947

Elev. 1986' **REPORT**

9/24 8" @ 235'
WOC

10/1 Drlg. 3125'

10/8 Lansing 3112'
BKC 3371'
Arbuckle 3434'
TD 3470'
5" @ 3470'
RUST

10/15 "

10/22 311 shots 3120-3362-
6500 acid

10/5 Arbuckle 3434'
5" @ 3470'
Perf.
Total Depth 3470'

ABANDONED

Map No. _____ Sec. 18 Twp. 9 R. 16W

Well No. 1 Bell

_____ Cities Service _____ Company

FIRST REPORT

_____ Contractor

SE/C


SECTION PLAT

_____ Ft. from N. Line

330 Ft. from S. Line

330 Ft. from E. Line

_____ Ft. from W. Line

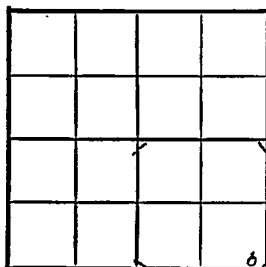

Rooks County

Location _____

Rig up _____

Drilling and Remarks:

8" @ 235 WOC

RECORD

Cased _____ in., _____ ft.

Sand _____

Gas _____

Oil _____

Total Depth _____

PRODUCTION

1st 24 hrs. Nat. _____

1st 24 hrs. after shot _____

Gas _____ Cu. Ft.

Dry Hole _____

Abandoned _____

Date

SEP 24 1947 19

S. J. LEWIS Scout

Map No. 64 Sec. 18 Twp. 9 R. 16W

Well No. 1 Bell

Cities Service

Company

ABANDONED

Contractor

SE/C

E. J. 1986
SECTION PLAT

			6

 Ft. from N. Line

330 Ft. from S. Line

330 Ft. from E. Line

 Ft. from W. Line

Rooks County

Location

Rig up

Drilling and Remarks:

Cor 83434
51103470
Perf.

RECORD

Cased in., ft.

Sand

Gas

Oil

Total Depth 3470

PRODUCTION

1st 24 hrs. Nat.

1st 24 hrs. after shot

Gas Cu. Ft.

Dry Hole

Abandoned

Date

NOV 5 1947 19

S. J. LEWIS

Scout