Rooks KANSAS

SECTION 18 TOWNSHIP 9S RANGE 16W

WELL NO. #1 Dougherty

COMPANY Murfin & Osage

NORTH NW SE SW

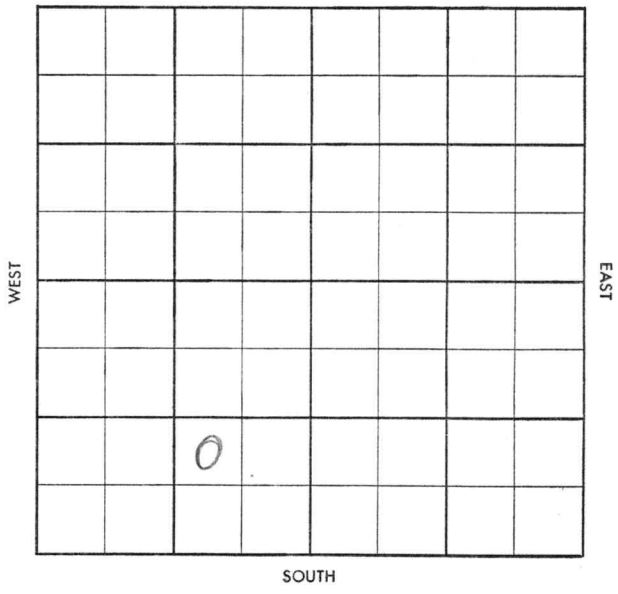

FORM 504-3 SUNRAY

S-513-B

County Rooks Elev.

Sec. 18 Twp. 9 Rge. 16w

Company Murfin & Osage

Farm Name Dougherty No. 1

TOPS	DEPTH	LOG	DATUM
Anh.			
Tp.			
H.			
Tr.			
Dg.			
B. L.			
L.			
K.C.			
B.K.C.			
Ce.			
C.			
M.			
M.			
K.			
Mz.			
Mq.			
V.			
S.			
S.			
A.			
R.			
Pf.			
G.			
T.D.			

Loc. in Sec. NW SE SW

Geol.

Contr. Co. Tools

Pool Westhusin

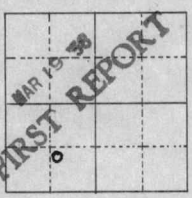

Date Comm.

WORT

Co. Lse. No. Sec. T. R.

Twp. X Pool X

Co. X Pool X

S-513-B

County Rooks Elev. 2009 DF 2012 RB

Sec. 18 Twp. 9 Rge. 16w

Company Murfin & Osage

Farm Name Dougherty No. 1

TOPS	DEPTH	LOG	DATUM
Anh.	1239		
Tp.	2881		
H.			
Tr.			
Dg.			
B.L.			
L.	3140		
K.C.			
B.K.C.	3362		
Ce.			
C.			
M.			
M.			
K.			
Mz.			
Mq.			
V.			
S.			
S.			
A.	3441		
R.			
Pf.			
G.			
T.D.	3455		

Loc. in Sec. NW SE SW

Geol.

Contr. Co. Tools

Pool Westhusin

ABANDONED

APR 16 '58

Date Comm. 3-17-58

WORT MAR 26 '58 APR 2 '58 8" 184/140 ø2870

APR 9 '58 DST 3041-75 op/hr 815'

SW BHP 1043 DST 3190-3216

op 90" 240' gip rec 70' V oily

m 2' MO 1' oil BHP 678 DST

3238-53 op 30" rec M SPS oil

BHP 343 DST 3440-45 op 2hrs

15' M SPK oil BHP 617 DST 3445

-55 op/hr 2357 SW BHP 1038

APR 16 '58 D & A

Co. Lse. No. Sec. T. R.