

KANSAS


FORM 51 IOM. 12-46 PETROL

Rooks county

Section 18 Township 9 Range 18-W

Well No. #1, Peck

Company Harry Gore

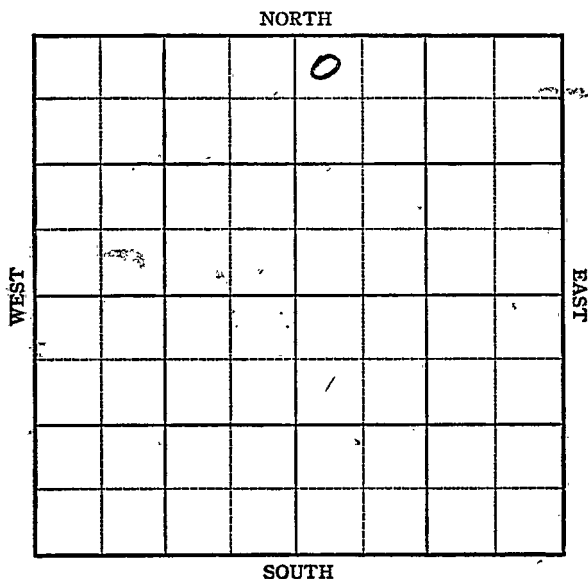

KANSAS

Rooks County

Sec. 18

Twp. 9

R. 18-W

Well No. #1 Peck Farm

Harry Gore Company

Wildcat


330' Ft. from N. Line

Ft. from S. Line

Ft. from E. Line

330' Ft. from W. Line

NW NE

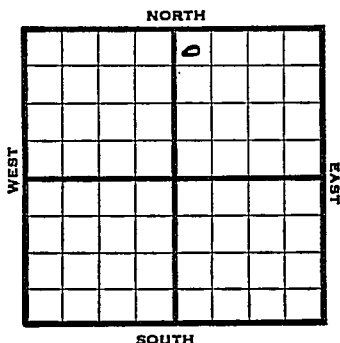

1947

Elev. 2074

REPORT

1/15 R U R

1/21 10" @ 255
DBlg 1169'


2/53 330' D 3630'
Lans 3259
Arb 3600

ABANDONED

Map No. 64 Sec. 18 Twp. 9 R. 18WWell No. 1 PeckHarry Gore Company**FIRST REPORT** Contractor

NW NE

SECTION PLAT

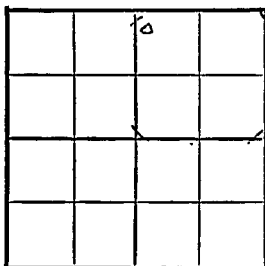330 Ft. from N. Line Ft. from S. Line Ft. from E. Line330 Ft. from W. Line

Rooks County

Location Rig up

Drilling and Remarks:

R U R

RECORD

Cased in., ft.Sand Gas Oil Total Depth

PRODUCTION

1st 24 hrs. Nat. 1st 24 hrs. after shot Gas Cu. Ft.Dry Hole Abandoned

Date

JAN 15 1947 19 S. J. LEWIS Scout

Map No. 64 Sec. 18 Twp. 9 R. 18W

Well No. 1 Peck

Harry Gore Company

ABANDONED

Contractor

NW NE

E12074

SECTION PLAT

330 Ft. from N. Line

 Ft. from S. Line

 Ft. from E. Line

330 Ft. from W. Line

		0	

Rooks County

Location

Rig up

Drilling and Remarks:

Line 3257

Or 3600

RECORD

Cased in., ft.

Sand

Gas

Oil

Total Depth 3680

PRODUCTION

1st 24 hrs. Nat.

1st 24 hrs. after shot

Gas Cu. Ft.

Dry Hole

Abandoned

Date

FEB 5 1947 19

S. J. LEWIS Scout