

KANSAS


Rooks

Section 18 Township 9 Range 18-WWell No. #1 New "A"Company Bridgeport
Wildcat

NORTH

WEST

EAST

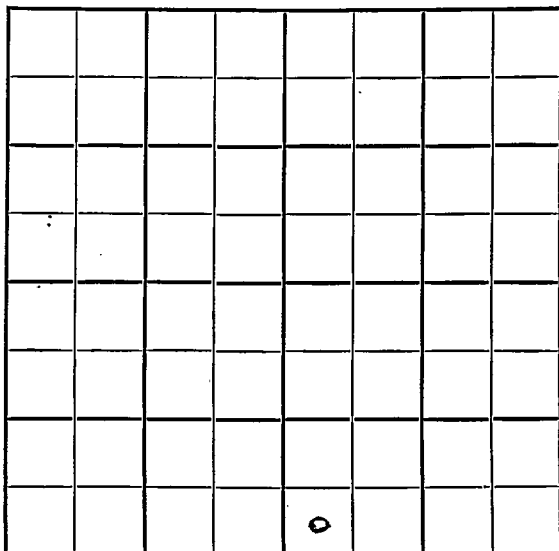

SOUTH

KANSAS

Rooks

Sec. 18 Twp. 9 R. 18W

Well No. #1 Neu "A" Farm

Bridgeport Company

Wildcat


 Ft. from N. Line

330 Ft. from S. Line

 Ft. from E. Line

330 Ft. from W. Line

SW SE

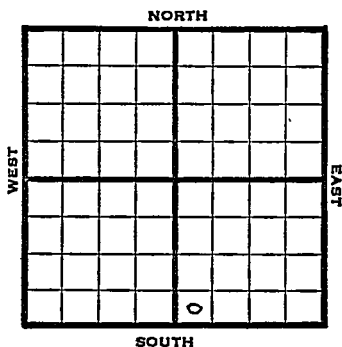

1948

Elev. 2138' REPORT

6/1
6/9

RUR
8" @ 192'
Dr1g 2915'

6/16

TD 3671'
Lansing 3326'
Cong 3573'
Arb. 3658'
Aband

ABANDONED

Map No. _____ Sec. 18 Twp. 9 R. 18W

Well No. 1 Neu "A"

Bridgeport Company

FIRST REPORT

Contractor

SW SE

SECTION PLAT

_____ Ft. from N. Line

330 Ft. from S. Line

_____ Ft. from E. Line

330 Ft. from W. Line

Rooks County

Location _____

Rig up _____

Drilling and Remarks:

R U R

RECORD

Cased _____ in., _____ ft.

Sand _____

Gas _____

Oil _____

Total Depth _____

PRODUCTION

1st 24 hrs. Nat. _____

1st 24 hrs. after shot _____

Gas _____ Cu. Ft.

Dry Hole _____

Abandoned _____

Date

JUN 1 1948 19 S. J. LEWIS Scout

Map No. 64 Sec. 18 Twp. 9 R. 18W

Well No. 1 Neu "A"

Bridgeport

Company

ABANDONED

Contractor

SW SE

E. 12138
SECTION PLAT

Ft. from N. Line

330 Ft. from S. Line

Ft. from E. Line

330 Ft. from W. Line

Rooks County

Location

Rig up

Drilling and Remarks:

Lans 8026
Cong 8028
Per 3158

RECORD

Cased in., ft.

Sand

Gas

Oil

Total Depth 3671

PRODUCTION

1st 24 hrs. Nat.

1st 24 hrs. after shot

Gas Cu. Ft.

Dry Hole

Abandoned

Date

JUN 16 1948

19

S. J. LEWIS Scout