

KANSAS

Rooks County

Sec. 18 Twp. 9 R. 18W

Well No. #1 Bedard Farm


Sinclair - Prairie Company

Barry
330 Ft. from N. Line

Ft. from S. Line

Ft. from E. Line

330 Ft. from W. Line

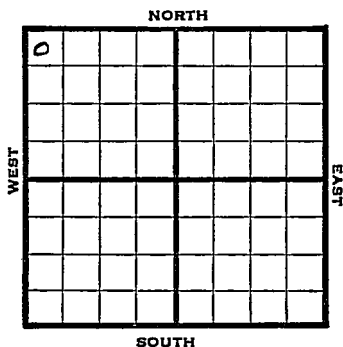

NW 1/4

1946 Elev. 2085' REPORT

10/9 Location
10/15 RUR
10/22 "
10/29 10" @ 1438' WOC
11/6 Drlg 2995'
11/12 Lans 3265'
BKC 3490
Cong 3515
Simp 3520'
Arb 3543
TD 3557
5" @ 3543, RUST
11/20 " "
11/27 " "
12/4 Arb 3543'
5" @ 3543'
TD 3566'

ABANDONED

Form 26 200 Bks 5-42 Petrol Kansas Barry

Map No. 64 Sec. 18 Twp. 9 R. 18WWell No. 1 BedardSinclair-Prairie Company

FIRST REPORT

Contractor

NW/C

SECTION PLAT

330 Ft. from N. Line Ft. from S. Line Ft. from E. Line330 Ft. from W. Line

<u>a</u>			

Rooks CountyLocation XRig up

Drilling and Remarks:

RECORD

Cased in., ft.Sand Gas Oil Total Depth

PRODUCTION

1st 24 hrs. Nat. 1st 24 hrs. after shot Gas Cu. Ft.Dry Hole Abandoned

Date

OCT 9 1946

19

S. J. LEWIS

Scout

Kansas

KANSAS


Barry Pool

Map No. 104 Sec. 18 Twp. 9 R. 18WWell No. 1 BedardSinclair-Prairie Company

ABANDONED

Contractor

NW/C

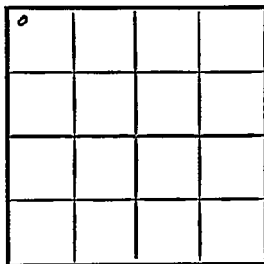E1.2085
SECTION PLAT330 Ft. from N. Line Ft. from S. Line Ft. from E. Line330 Ft. from W. Line

Rooks County

Location Rig up

Drilling and Remarks:

2135435103543

RECORD

Cased in., ft.Sand Gas Oil Total Depth 2566

PRODUCTION

1st 24 hrs. Nat. 1st 24 hrs. after shot Gas Cu. Ft.Dry Hole Abandoned

Date

DEC 4 1946 19 S. J. LEWIS Scout