


Section 18 Township 9 Range 18W

Well No. #1 Neu

Company Heathman & Seeligson

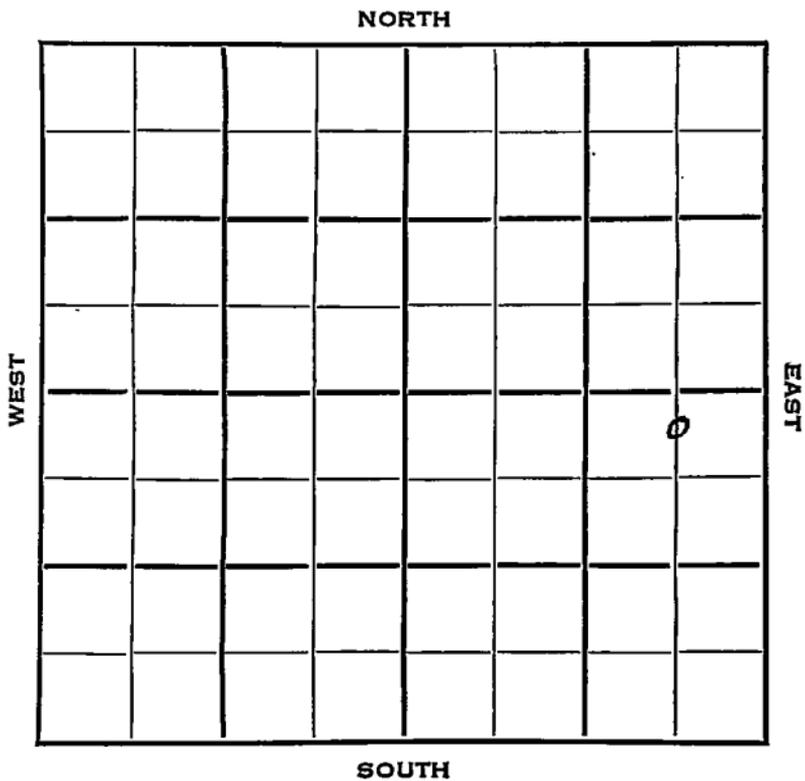

Rooks KANSAS


| | | |
|------|------|-------|
| SEC. | TWP. | R. |
| 18 | 9 | 18W ✓ |

WELL NO. 1 Neu FARM

COMPANY Heathman & Seeligson

CONTRACTOR

S. McHale Pool
 330 Ft. from N. Line
 Ft. from S. Line
 660 Ft. from E. Line
 Ft. from W. Line

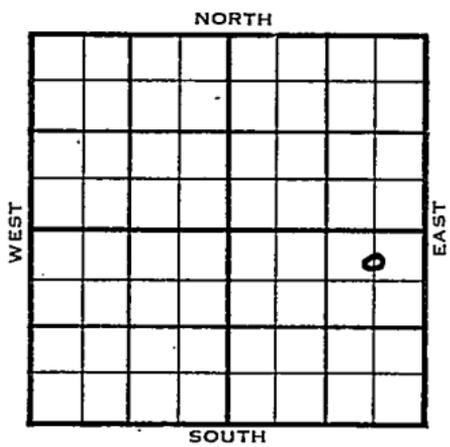

C N L NE SE

| | ELEVATION | REPORT |
|------|-----------|--------|
| 1954 | 2148' | |

| | |
|------------------|--|
| 3/10 | Spud 3-5-54 8" @ 160' Dr1g. 2415' |
| 3/17 | Spud 3-5-54 D&A TD 3602' 8" @ 160' Heeb 3306', Lans 3346', Cong 3589' TD 3602' D&A |
| ABANDONED | |

County **Rooks** State **Kansas**

Sec. **18** (Blk.) **9** (Sur.) **18W** Map No.

Operator **Heathman & Seeligson**

Well No. **1** Farm **Neu**

Elev. Location **C N L NE SE**

| | | | | | |
|--|--|--|--|--|--|
| | | | | | |
| | | | | | |
330 Ft. From **N** Line **SE**

660 Ft. From **E** Line Quarter

Ist. Report **MAR 10 1954**

Completion

Remarks

Spudding Date **3-5-54**

Drlg. Data **S. McHale Pool**

8" @ 160 drlg. 2415

County Rooks State Kansas

Sec. 18 (Blk. Twp.) 9 (Sur. Rge.) 18W Map No.

Operator Heathman & Seeligson

Well No. 1 Farm Neu

Elev. 2148 Location C N L NE SE

| | | | | | |
|--|--|--|--|--|--|
| | | | | | |
| | | | | | |
.330 Ft. From N Line SE

660 Ft. From E Line Quarter

1st. Report

Completion MAR 17 1954

Remarks S. McHale Pool

Spudding Date 3-5-54

Drlg. Data D & A TD 3602

8" @ 160 Heeb. 3306 Lans. 3346

Cong. 3589 TD 3602

D & A