


Section 18 Township 9 Range 19 W

Well No. # 1 Marcotte

Company Mallonee Drlg. //

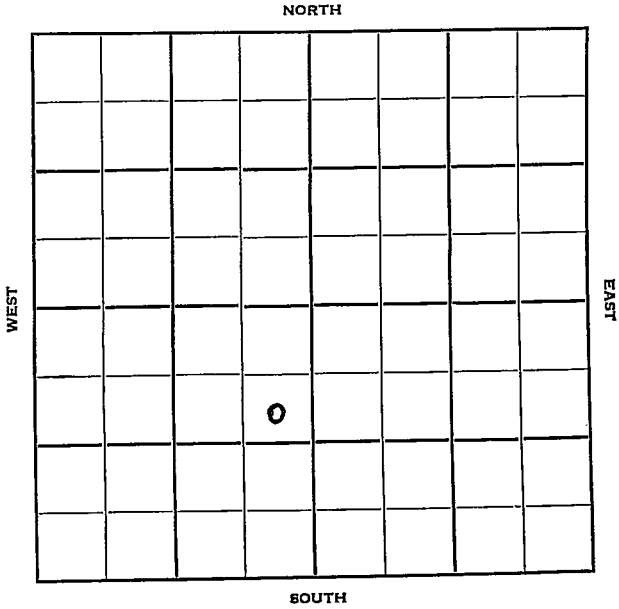

Rooks

KANSAS 19W

Sec. 18 Twp. 9 R.

Well No. #1 Marcotte Farm

Mallonee Drlg. Company

Contractor


990' Ft. from N. Line

Ft. from S. Line

330' Ft. from E. Line

Ft. from W. Line

SE NE SW

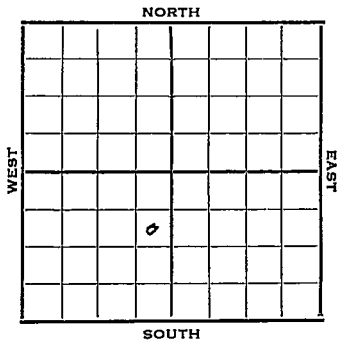

1952 Elev. 2065' REPORT

5/14 Spud 5-10-52  
8" @ 178  
Drlg. 1620'

5/21 Drlg. 3314'

5/28 Spud 5-10-52  
D & A TD 3595' 8" @ 178  
Top 3031' Heeb 3240' Tor. 3261'  
DST 3246-71 open 1 hr. rec 10' mud  
Lans. 3278'  
DST 3330-48 open 1 hr. rec 3' oil,  
27' OCM  
DST 3356-69 open 1 1/2 hr, rec 195' sul.  
water.  
DST 3372-80 open 1 hr. rec 10' SOCM  
Arb. 3587' TD 3595' D & A

**ABANDONED**

County Rooks State Kansas

Sec. 18 (Blk. Twp.) 9 (Sur. Rge.) 19W Map No.

Operator Mallonee Drlg.

Well No. 1 Farm Marcotte

Elev. Location SE NE SW

FIRST REPORT					
		o			

990 Ft. From W Line SW

330 Ft. From E Line Quarter

Ist. Report MAY 14 1952

Completion

Remarks Champlin support

Spudding Date 5-10-52

Drlg. Data  
8" @ 178 drlg. 1620

