FORM 51 10M 7-48 PETROL

KANSAS Rooks


Section 18 Township 9 Range 19W

Well No. 1 Rempe

15

Company Champlin Ref.

Marcotte Pool

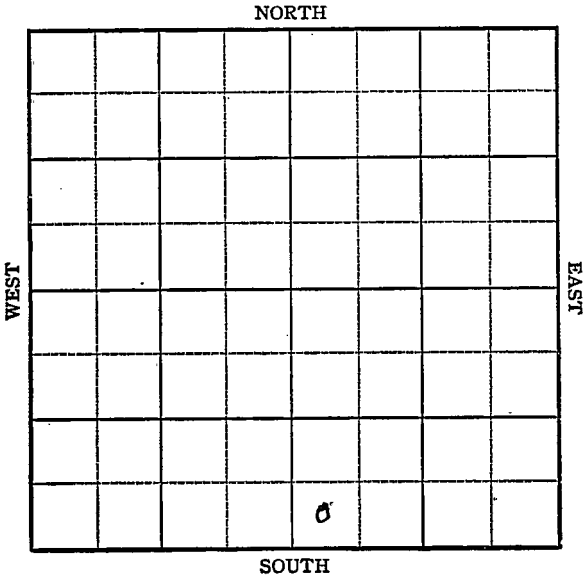

FORM 252-A - 5M 10-48 PETROL

KANSAS Rooks ✓

Sec. 18 Twp. 9 R. 19W

Well No. #1 Rempe Farm

Champlin Ref. Company

Marcotte Pool


____ Ft. from N. Line

330' Ft. from S. Line

____ Ft. from E. Line

330' Ft. from W. Line

SW SE

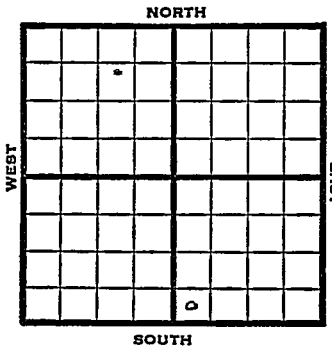

1949	Elev 2070' REPORT
1/12	Location
1/19	8"@ 171'
	Drlg 2650'
1/26	Arb. 3534-38'
	TD 3438'
	4"@ 3538'
2/2	Lansing 3277'
2/9	"
2/16	"
2/23	TD 3551' SO
3/2	500 acid
3/8	"
3/16	"
3/23	"
3/30	"
4/6	"
4/12	"
4/20	TD 3566'
	1500 acid
4/27	PB 3358
	24 shots 3348-56
	250 acid
	1 bbl oil PB
5/4	"
5/10	"
5/18	"
5/25	"
6/1	"

OVER

1949

6/8 Arb. 3534'
4"@ 3538'
TD 3566'
1750 acid
Pump 13 oil Pot
28° Gr.
Comp

COMPLETED

Form 26 200 Bks. 9-48 Petrol
Kansas

Marcotte Pool

Map No. _____ Sec. 18 Twp. 9 R. 19W


Well No. 1 Rempe

Champlin Ref. Company

FIRST REPORT Contractor

SW SE

SECTION PLAT

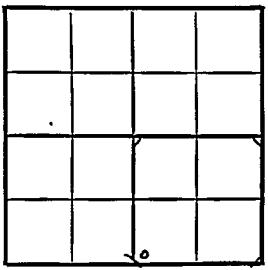

_____ Ft. from N. Line

330 Ft. from S. Line

_____ Ft. from E. Line

330 Ft. from W. Line

Rooks County

Location x

Rig up

Drilling and Remarks:

RECORD

Cased _____ in., _____ ft.

Sand

Gas

Oil

Total Depth

PRODUCTION

1st 24 hrs. Nat.

1st 24 hrs. after shot

Gas _____ Cu. Ft.

Dry Hole

Abandoned

Date

JAN 1 2 1949 19

S. J. LEWIS Scout

Form 27—100 Bks.—4-48—Petrol

Rooks County Kansas State

Map No. K 65 Sec. 18 Twp. 9 R. 19W

Well No. 1 Rempe


Champlin Ref. Company

COMPLETE Contractor

SW SE

El. 2070

SECTION PLAT

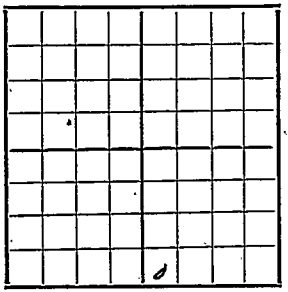

____ Ft. from N. Line

330 Ft. from S. Line

____ Ft. from E. Line

330 Ft. from W. Line

Marcotte Pool

Remarks:

Cr + 3534

4" @ 3538

TD 3566.

1250 acid

Pump 13 bbl BO +

25% Gr

Date JUN 8 1949

Scout S. J. LEWIS