


KANSAS Rooks

Section 18 Township 9 Range 19WWell No. 1 MarcotteCompany Aylward Prod. et al

Wildcat

NORTH

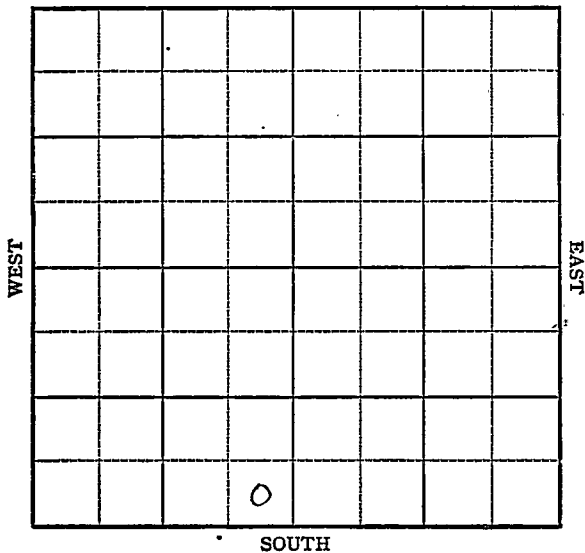

KANSAS

Rooks

Sec. 18 Twp. 9 R. 19W

Well No. #1 Marcotte Farm

Aylward Prod. et al Company

Wildcat


Ft. from N. Line

330' Ft. from S. Line

330' Ft. from E. Line

Ft. from W. Line

SE SW

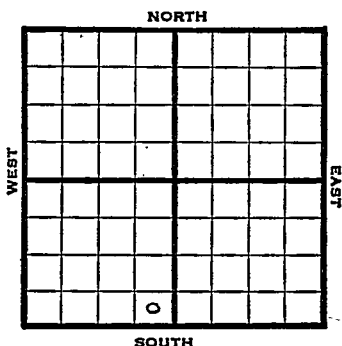

1948

Elev. 2075'

REPORT

8/18

Location

8/25

Surface Hole

9/1

8" @ 160'

Drlg. 2407'

9/8

Lansing 3280'

Arb. 3548'

TD 3550

5" @ 3548'

9/14

TD 3595' 1 bbl W PH

9/21

"

9/29

20 shots 3370-75

Swb 35 bbls oil / 22 W in 7 hrs.

10/6

"

10/13

"

10/19

"

10/26

"

11/3

Lans 3280'

Arb. 3548'

5" @ 3548'

Berf Lans

Pump 91 oil & 20% W Pot.

Gr. 27°

TD 3550'

COMPLETED

Rooks County Kansas State

Map No. _____ Sec. 18 Twp. 9 R. 19W

Well No. 1 Marcotte

Aylward Prod. etal. Company

FIRST REPORT Contractor

SE SW

SECTION PLAT

_____ Ft. from N. Line

330 Ft. from S. Line

330 Ft. from E. Line

Ft. from W. Line

Wilcat

Remarks:

Remarks:

Location

Date
AUG 18 1948

Scout **S. J. LEWIS**

Map No. 65 Sec. 18 Twp. 9 R. 19W

Well No. 1 Marcotte

Aylward Prod. etal. Company

COMPLETE

Contractor

SE SW


E1, 2075
SECTION PLAT

 Ft. from N. Line

330 Ft. from S. Line

330 Ft. from E. Line

 Ft. from W. Line

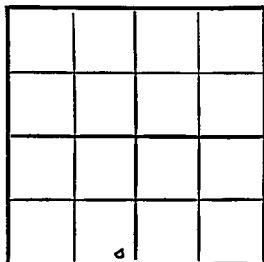

Rooks County

RECORD

Location

Cased in., ft.

Rig up

Sand

Drilling and Remarks:

Gas

Line 3280

Oil ✓

CR + 3548

Total Depth 3550

5" @ 3548

Prof. house

Prod 91 oil + 20%

W B &

PRODUCTION

1st 24 hrs. Nat.

1st 24 hrs. after shot

Gas Cu. Ft.

Dry Hole

Abandoned

Date

27th Nov

NOV 3 1948 19

S. J. LEWIS Scout