


Section 18 Township 9 Range 20W

Well No. #1 Miller

Company D. G. Hansen

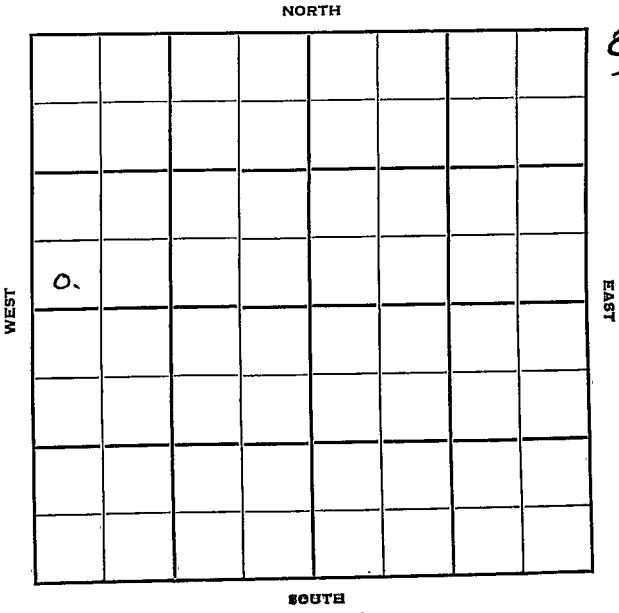

Rooks

KANSAS

Sec. 18 Twp. 9 R. 20 W

Well No. # 1 Miller Farm

D. G. Hansen Company

G & G Drlg. Contractor

Gray-Rock Pool


Ft. from N. Line

330 Ft. from S. Line

Ft. from E. Line

330 Ft. from W. Line

SW SW NW

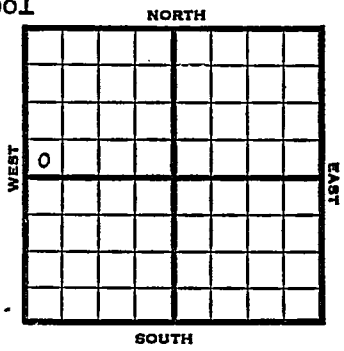

1951

Elev. 2171' REPORT

8/8

Spud 8-5-51  
8" @ 240  
Drlg. 1843'

8/22

Spud 8-5-51 D & A TD 3779'  
8" @ 240 Anhy 1665' Heeb 3392'  
KC 3434' Cong. 3701'  
DST 3701-15 open  $\frac{1}{2}$  hr. rec 20' mud  
TD 3779' D & A

~~ABANDONED~~

County Rooks State Kansas

Sec. 18 (Blk. Twp.) 9 (Sur. Rge.) 20W Map No.

Operator D. G. Hansen

Well No. 1 Farm Miller

Elev. 2171 Location SW SW NW

	FIRST REPORT				
0					

330 Ft. From S Line NW

330 Ft. From W Line Quarter

1st. Report AUG 8 1951

Completion \_\_\_\_\_

Remarks \_\_\_\_\_

C & G Drlg. - Contr.

Spudding Date 8-5-51

Drlg. Data Gray - Rock Pool

8" @ 240 drlg. 1843

